


T.1S.,R.8W.,W.M.

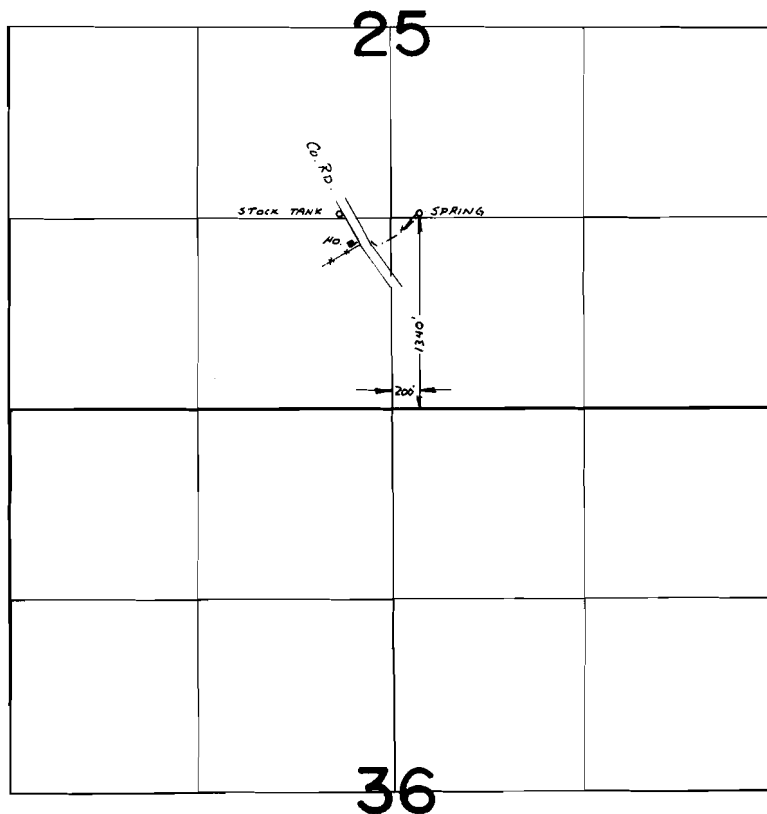

FINAL PROOF SURVEY
UNDER

Application No. 49976 Permit No. 37592
IN NAME OF

HOWARD PINKSTAFF

Surveyed JUNE 25 1975, by L. E. GOVLR