


T. 4 N. R. 27 E. W.M.

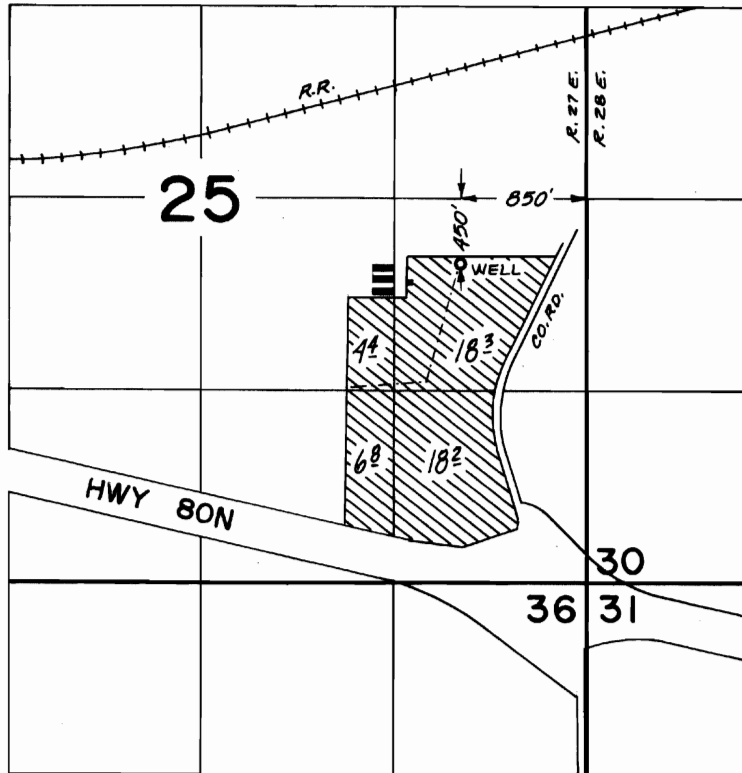

FINAL PROOF SURVEY UNDER

Application No. G 4427 Permit No. G 4171
IN NAME OF

E. T. JOHNSON

Surveyed APRIL 1 1975, by R. G. MUCKEN