


T.6N.R.35E.W.M.

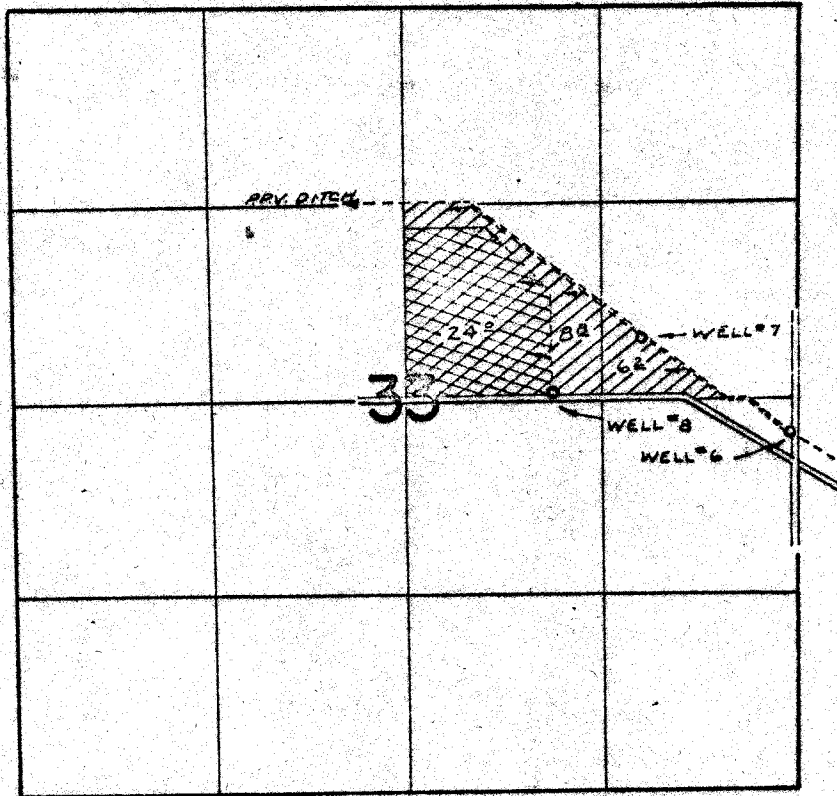

WELLS LOC: #6 - 280'S & 30'W; #7 - 420'N & 1040'W; #8 - 30'N & 1850'W, ALL FROM E 1/4 COR. SEC 33

FINAL PROOF SURVEY UNDER

G-5861
 G-5862
 Application No. ~~G-5863~~ Permit No. ~~G-5000~~

G-4998 → [diagonal hatching symbol]
 G-4999 → [diagonal hatching symbol]

IN NAME OF

.....WILLIAM.....J.....JACKSON.....

Surveyed APRIL, 1973., by R. MURKIN