


T.2 S. R.38 E. W.M.

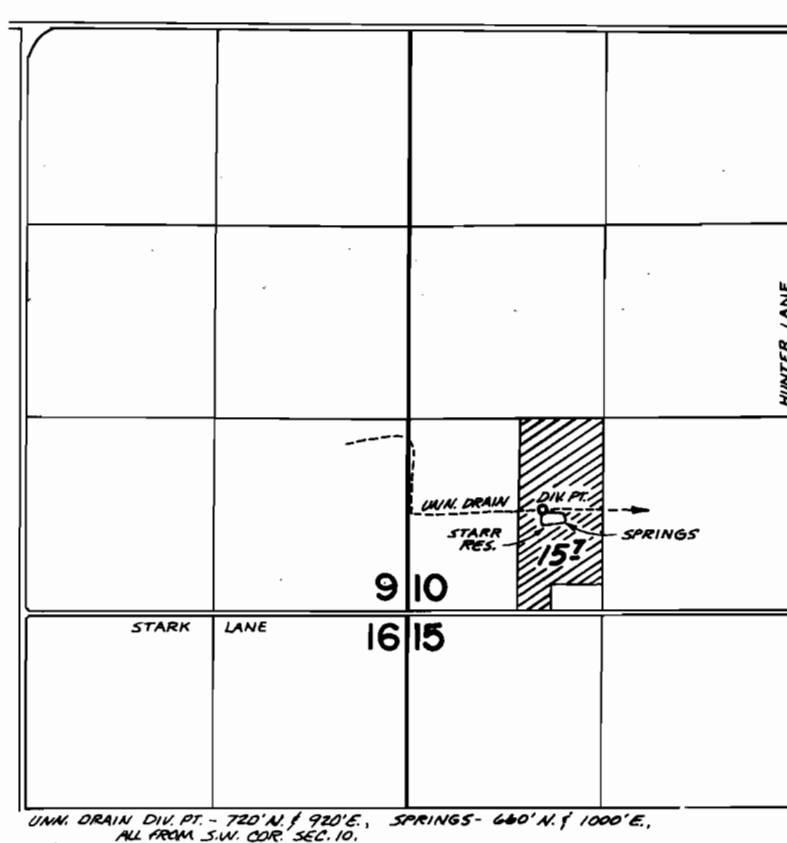

FINAL PROOF SURVEY
UNDER

R 46567 R5562
Application No. 46568 Permit No. 34805
IN NAME OF

W. W. Collingwood

Surveyed April 3, 1975, by D. Norby