


T.2 S. R.38 E. W.M.

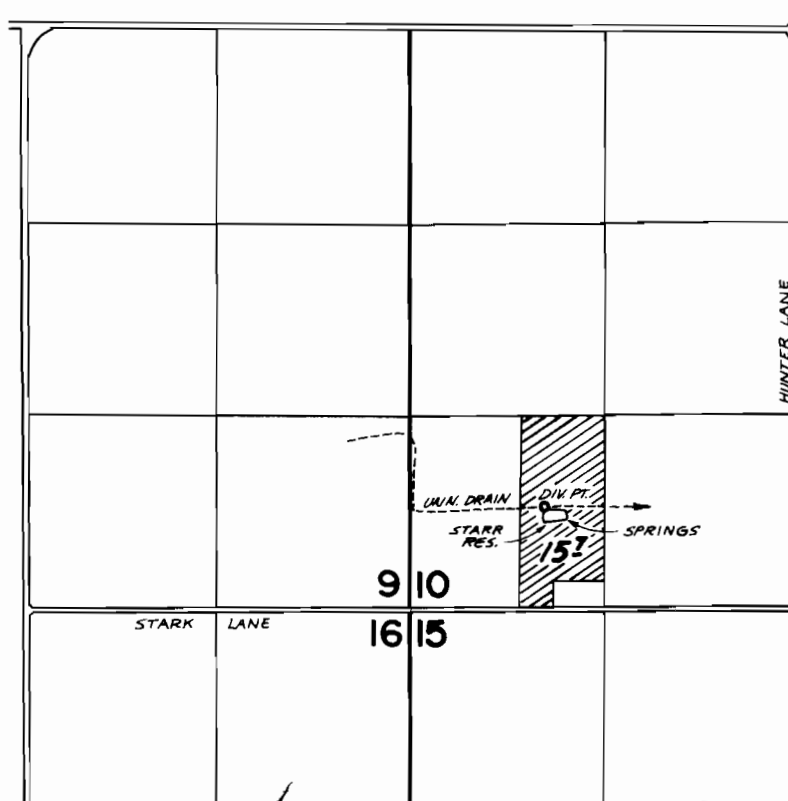

UNN. DRAIN DIV. PT. - 720' N. & 920' E., SPRINGS - 680' N. & 1000' E.,
ALL FROM S.W. COR. SEC. 10.

FINAL PROOF SURVEY
UNDER

R 46567 R5562
Application No. 46568 Permit No. 34805
IN NAME OF

W. W. Collingwood

Surveyed April 3, 1975, by D. Norby