


# T. 1 S. R. 12 & 13 E. W. M.

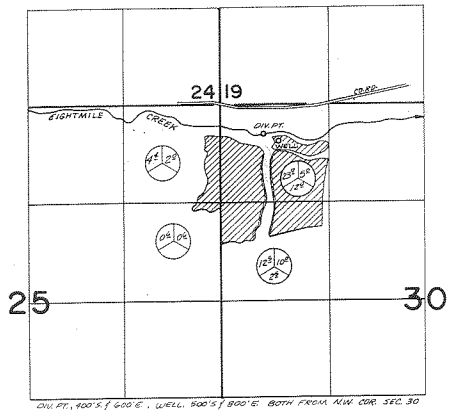

## FINAL PROOF SURVEY UNDER

Application No. G 4494      G 4236  
41623      Permit No. 31304  
 IN NAME OF  
August T. & Myrtle Gehrig  
 Surveyed JULY 18, 1975, by T. PAUL