


P# 33539

T.1S. R.12&13E. W.M.

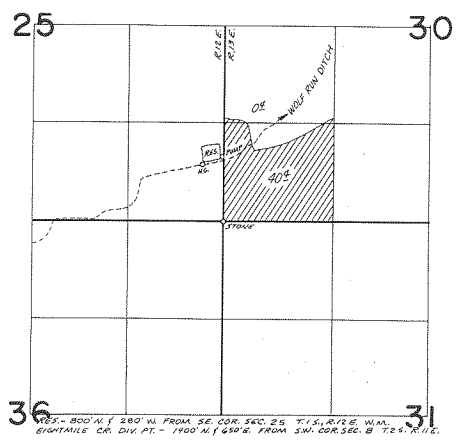

FINAL PROOF SURVEY UNDER

R 44825 R 5299
 Application No. 44826 Permit No. 33539
 IN NAME OF

The Miller Ranch Company

Surveyed JULY 15, 1975, by T. PAUL