


PER 5299

T.1S. R.12&13E. W.M.

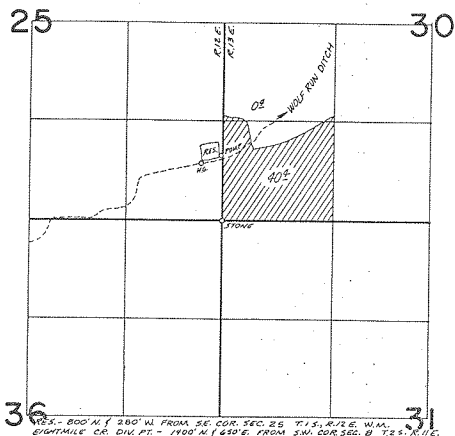

FINAL PROOF SURVEY
UNDER

R44825 R5299
Application No. 44826 Permit No. 33539
IN NAME OF

The Miller Ranch Company

Surveyed JULY 15 1975, by T. PAUL