


T.2S., R.2W., W.M.

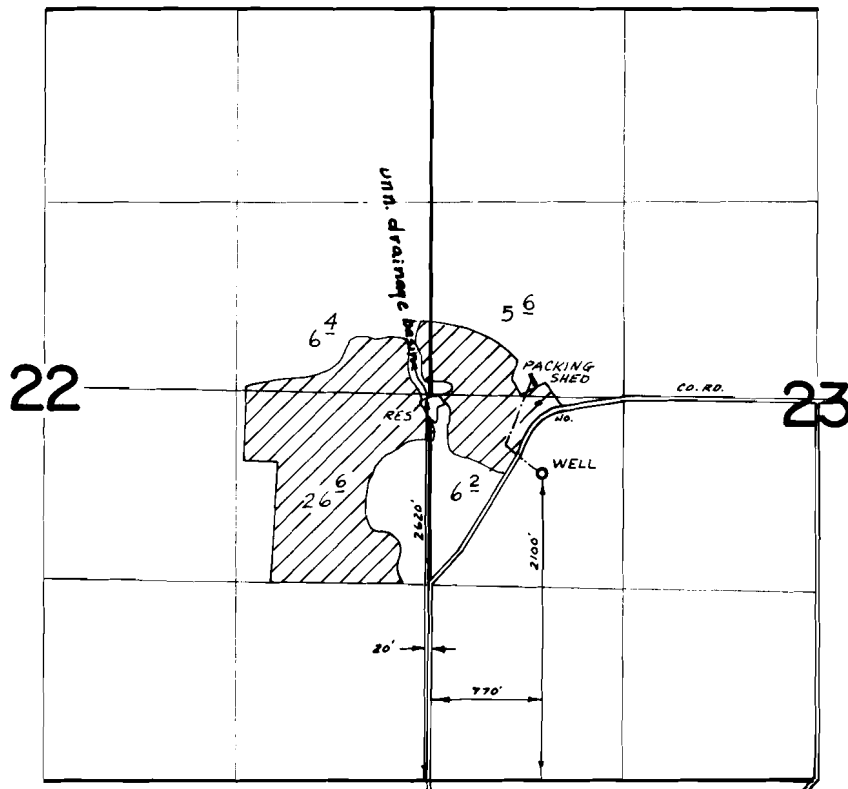

FINAL PROOF SURVEY
UNDER

G-2701 G-2505
R-41312 R-4660
Application No. 41313 Permit No. 30848
IN NAME OF

ARCHIE M. ERICKSON

Surveyed June 30 1975, by R.G. Mucken