


T.1N., R.5W., W.M.

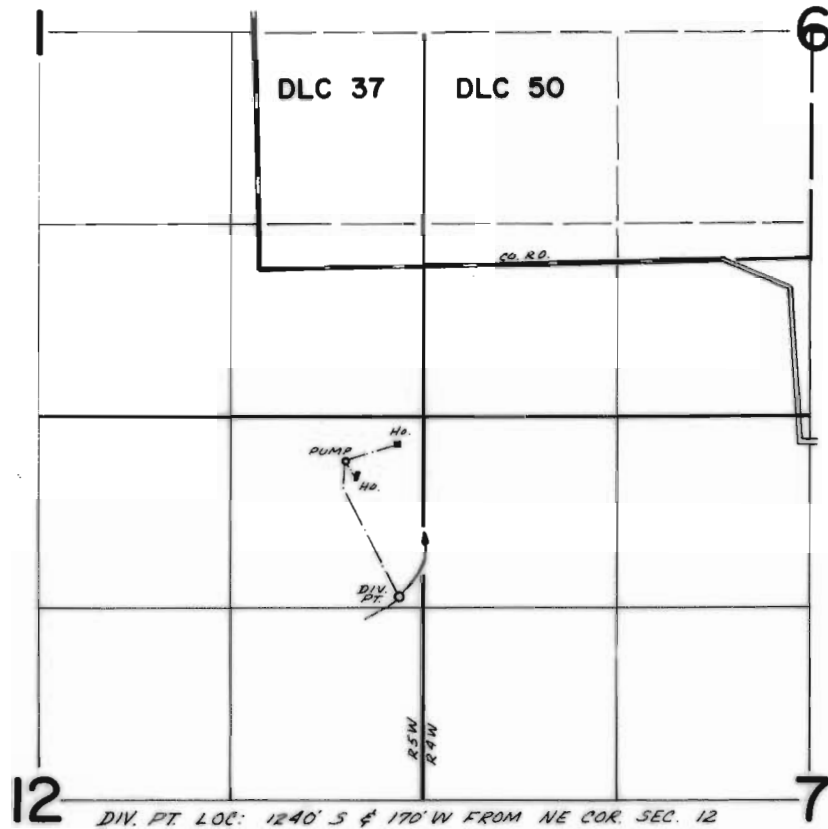

FINAL PROOF SURVEY
UNDER

Application No. 49382 Permit No. 36083
IN NAME OF

MELVIN RANES

Surveyed Oct. 7 1975, by D. Norby