


T.3N. R.3W. W.M.

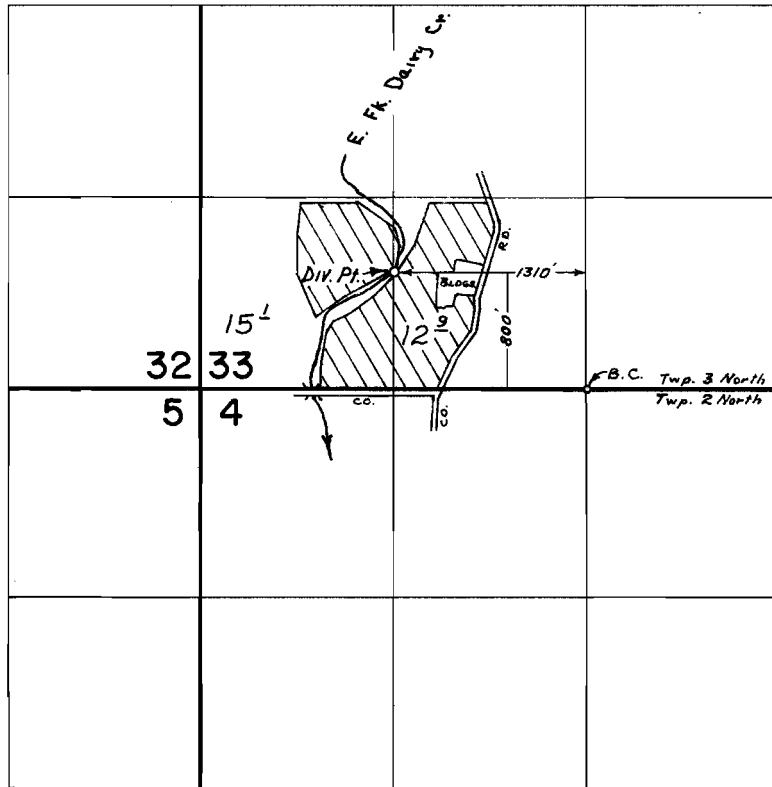

FINAL PROOF SURVEY

UNDER

Application No. 49929 Permit No. 37576

IN NAME OF

ELMO GARDNER

Surveyed Sept. 11, 1975, by R. Mucken