


T. 3 S. R. 5 W. W. M.

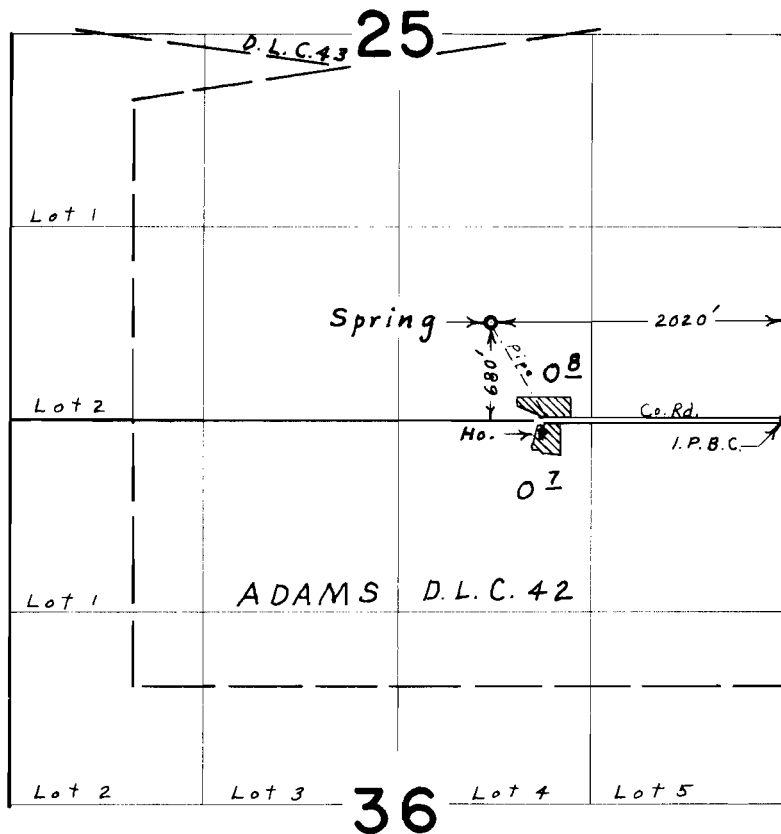

FINAL PROOF SURVEY
UNDER

Application No. 48004 Permit No. 36002
IN NAME OF

ARLENE D. & ROBERT R. LUOTO

Surveyed April 16, 1975, by L. E. Gould