


T.4 S. R.5 W. W.M.

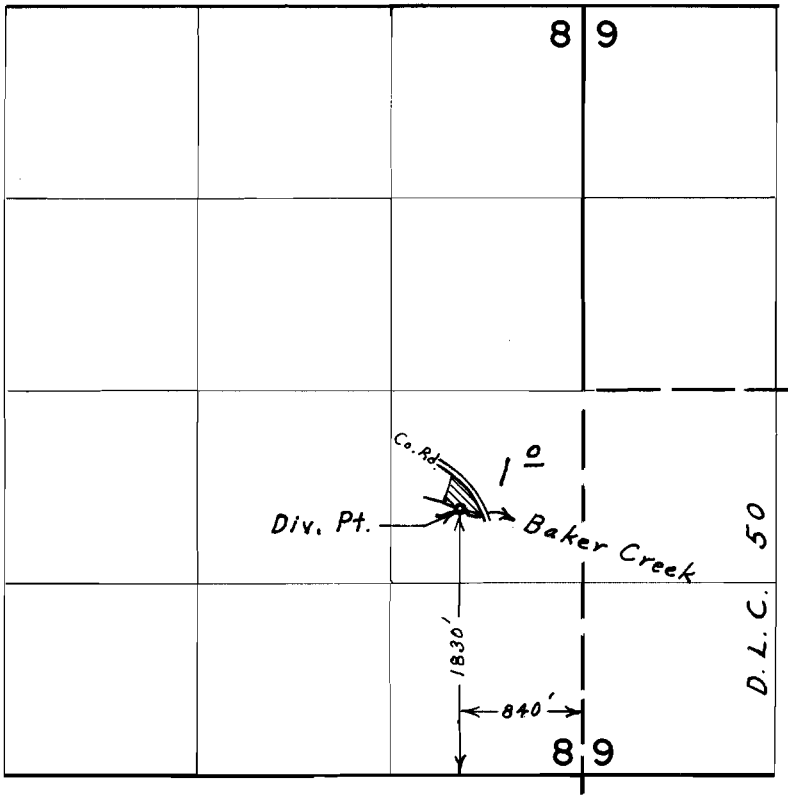

FINAL PROOF SURVEY

UNDER

Application No. 48302 Permit No. 36271
IN NAME OF

JERALD E. SMITH

Surveyed April 18, 1975, by L. E. Gould