


T.5 S. R.6 W. W.M.

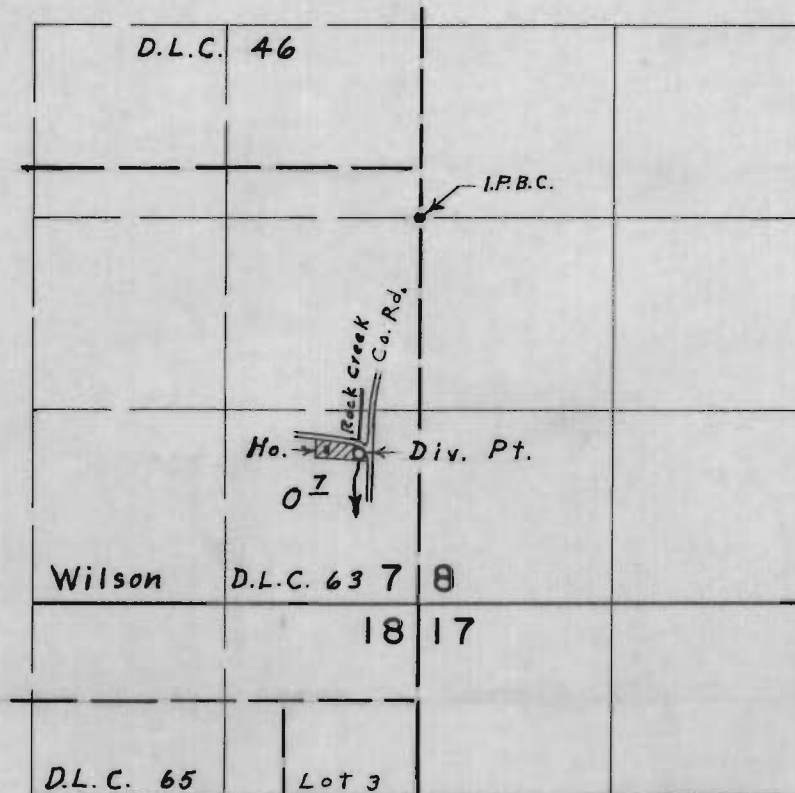

FINAL PROOF SURVEY
UNDER

Application No. 49521 Permit No. 37366
IN NAME OF

STEVEN S. & SALLY A. BROCK

Surveyed Sept. 3, 1975, by L. E. Gould