


T. 4 S. R. 3 W. W.M.

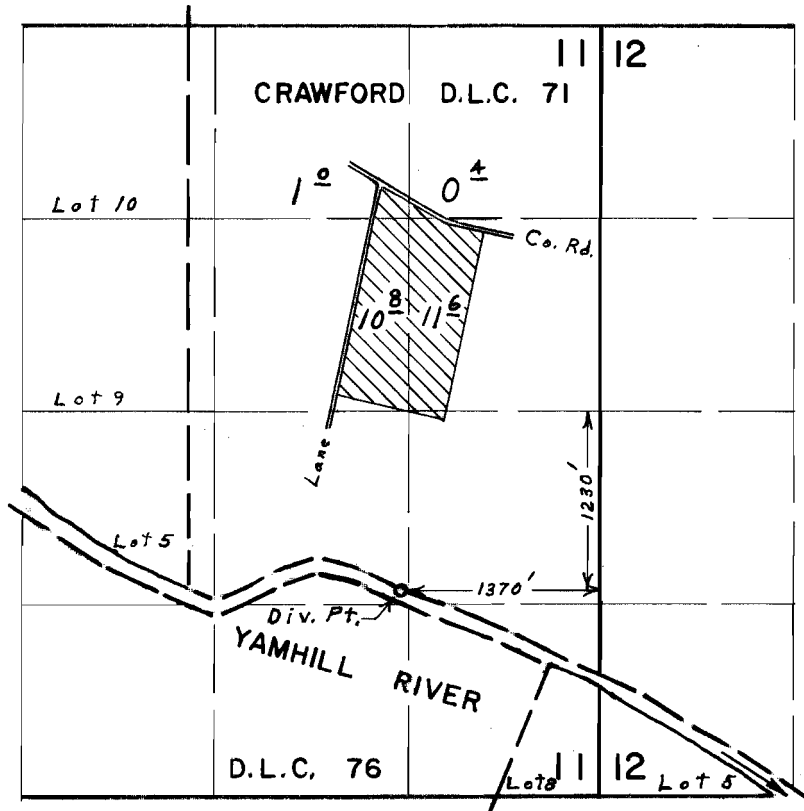

FINAL PROOF SURVEY UNDER

Application No. 50083 Permit No. 37635
IN NAME OF

JOHN (JACK) SHELBURNE

Surveyed Aug. 8, 1975 by L. E. Gould