


T.4 S. R.5 W. W.M.

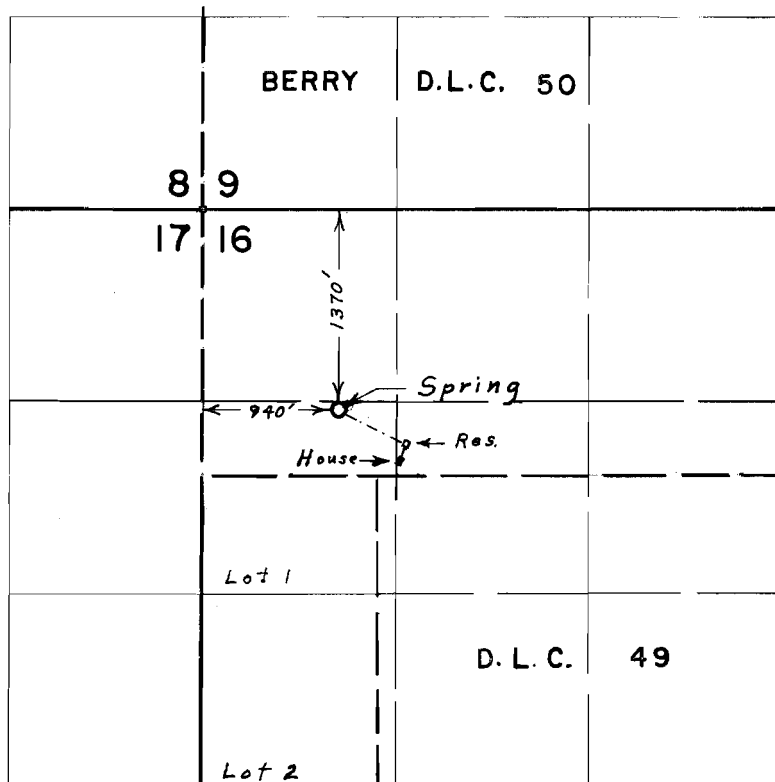

FINAL PROOF SURVEY UNDER

Application No. 50227 Permit No. 37706
IN NAME OF

ADRIAN L. & ELSIE L. MOORE

Surveyed Aug. 5, 1975, by L. E. Gould