


T.15S., R.5W., W.M.

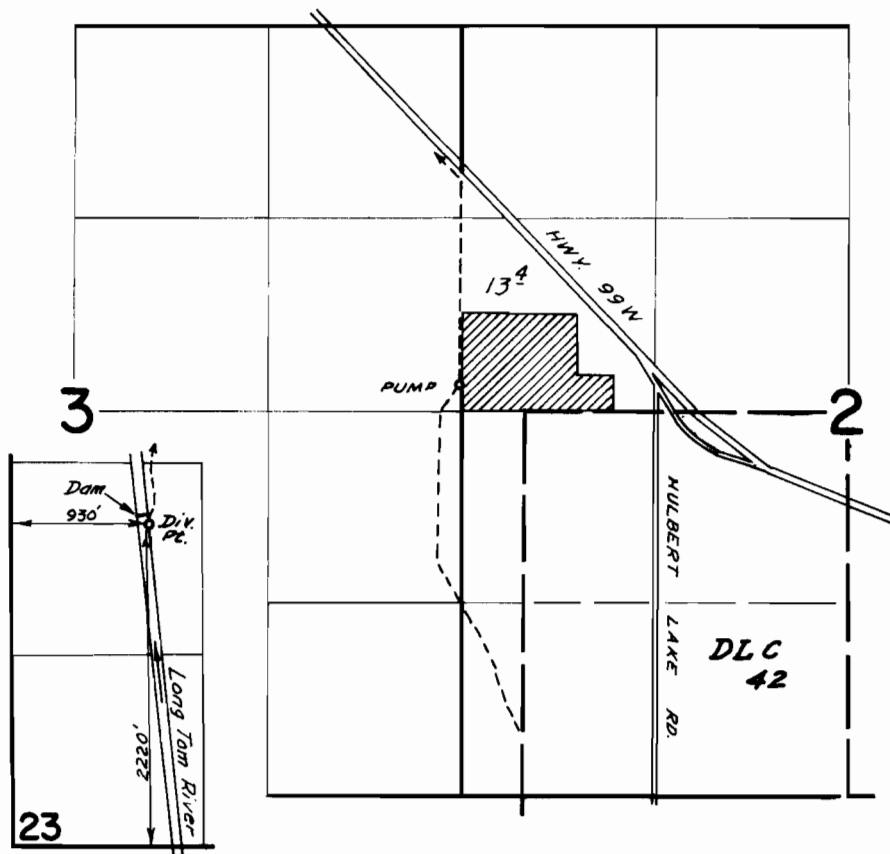

FINAL PROOF SURVEY
UNDER

Application No. 49178 Permit No. 36865
IN NAME OF

DANIEL A. SEAMAN

Surveyed April 21 1975, by D. Norby