


T.3S. R.1E. W.M.

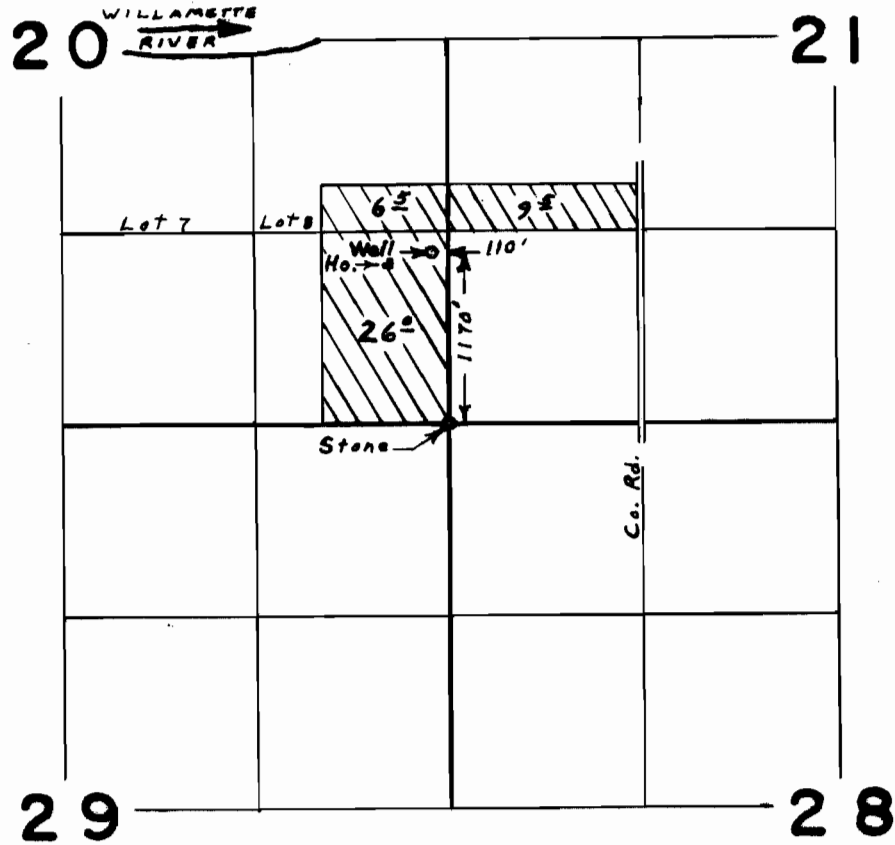

FINAL PROOF SURVEY UNDER

Application No. G-4827 Permit No. G-4546
IN NAME OF

HAROLD & GERALDINE M. MICKELSEN

Aug. 10, 1976, L. E. Gould
Surveyed AUG. 15, 1974, by L. H. NUNN