


T.20S. R.36E. W.M.

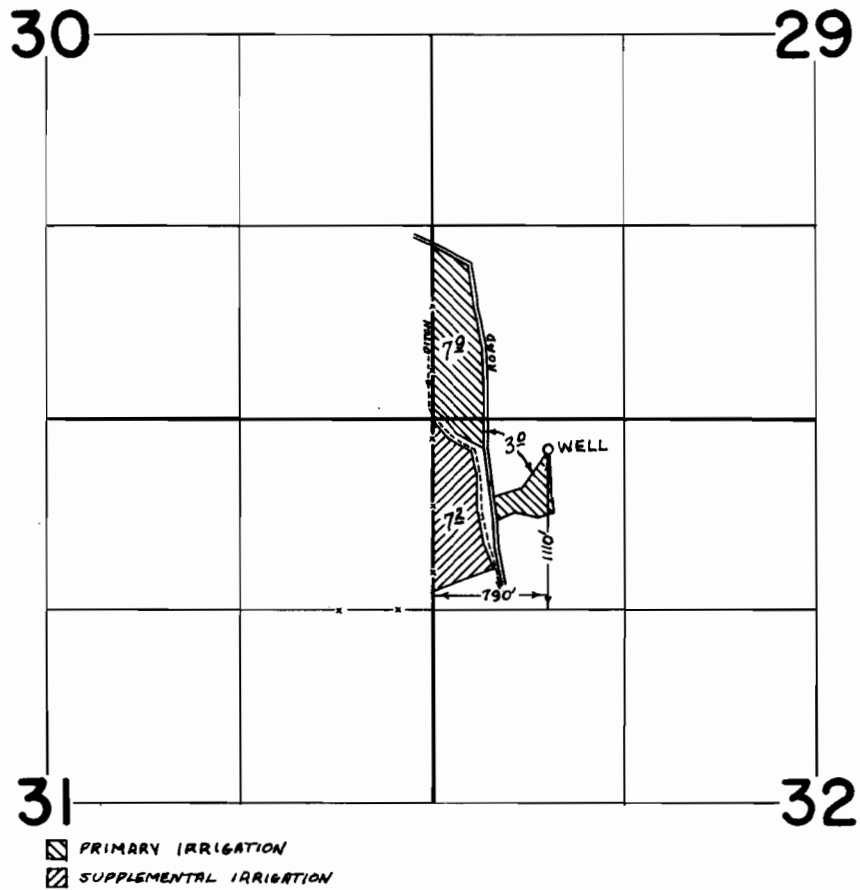

FINAL PROOF SURVEY
UNDER

Application No. G-3535 Permit No. G-3327
IN NAME OF

J. W. AND CAROL ROBERTSON

Surveyed JUNE 24 1975, by L. TOLL