


T.19S. R.36E. W.M.

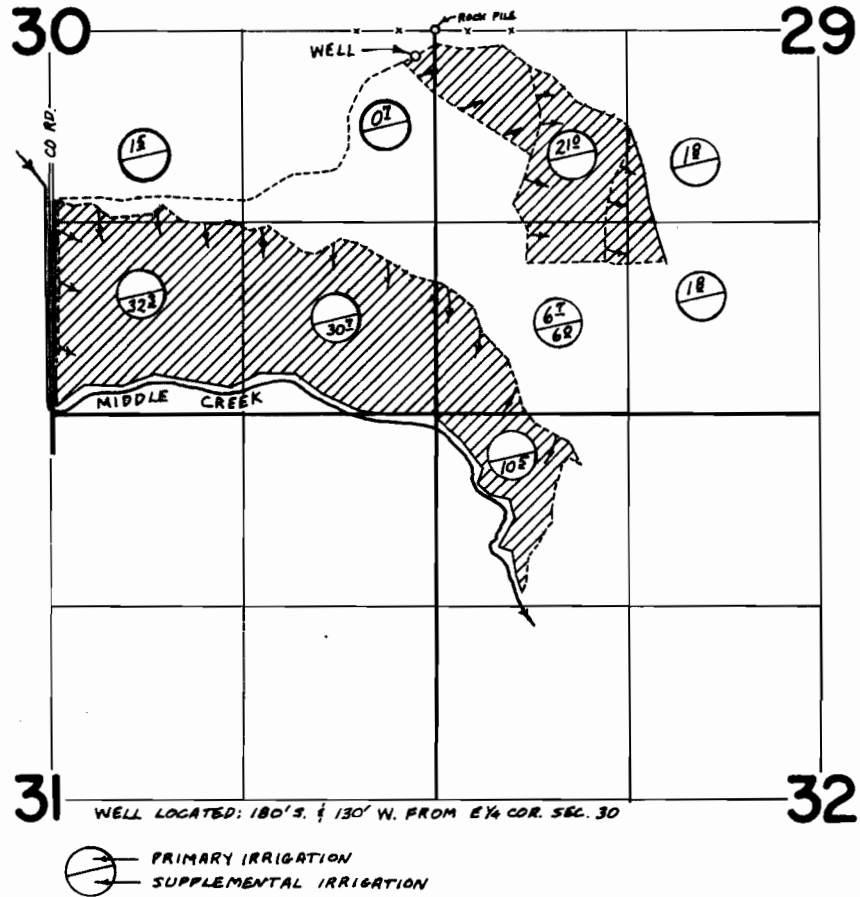

FINAL PROOF SURVEY
UNDER

Application No. G-3554 Permit No. G-3343
IN NAME OF

J. W. ROBERTSON

Surveyed JUNE 24 1975, by L. TOLL