


T.23S. R.34E. W.M.

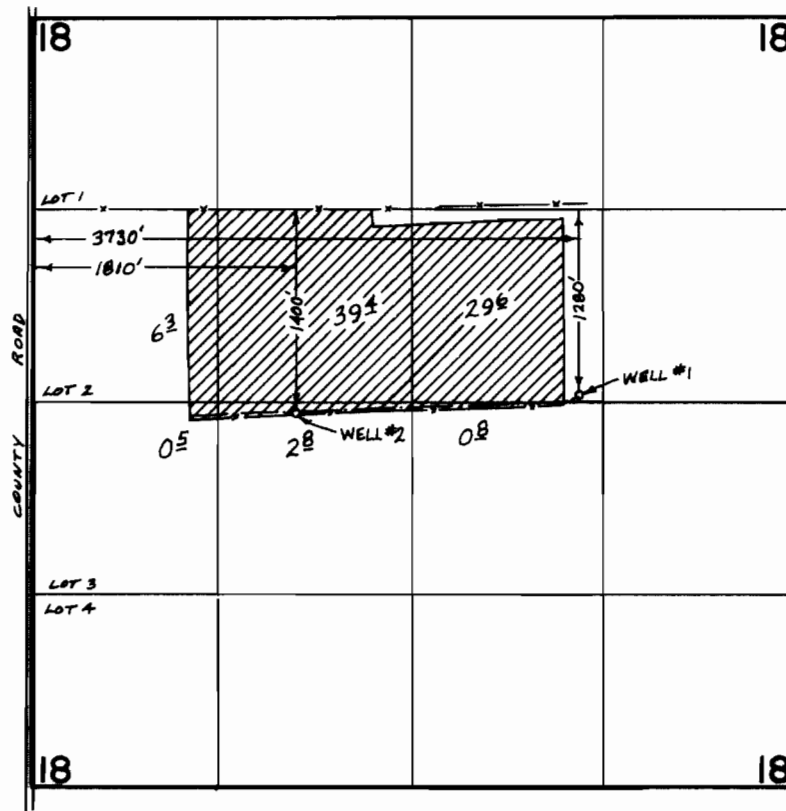

FINAL PROOF SURVEY
UNDER

Application No. G-3896 Permit No. G-3661
IN NAME OF

DICK ARNOLD

Surveyed JUNE 20 1975, by L. TOLL