


T.23S. R.31E. W.M.

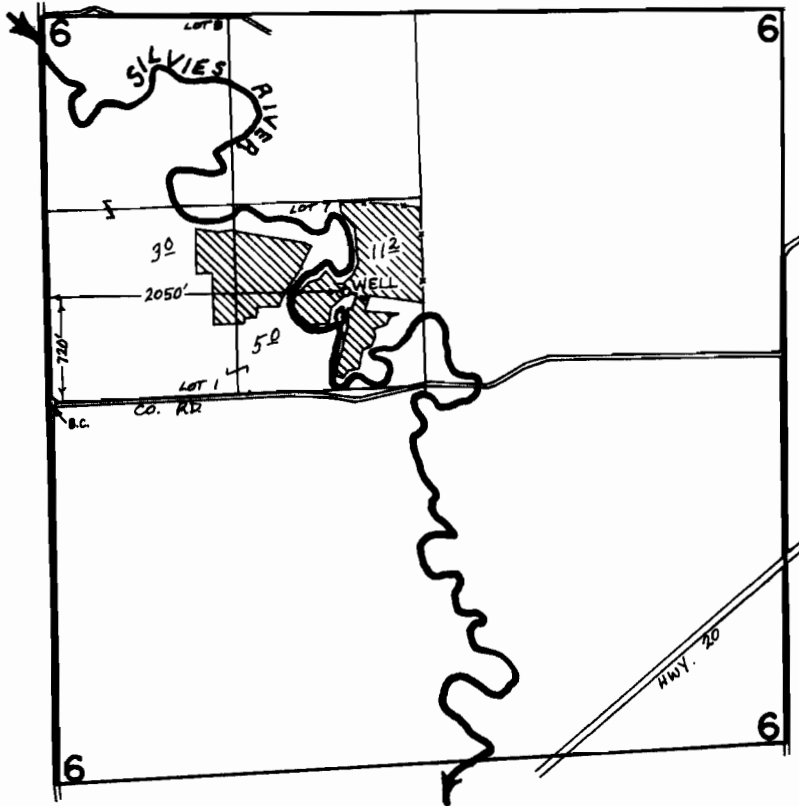

FINAL PROOF SURVEY

UNDER

Application No. G-4931 Permit No. G-4655
IN NAME OF _____

JOE C. TILLER

Surveyed JUNE 19 1975, by L. TOLL