


T.24S. R.31E. W.M.

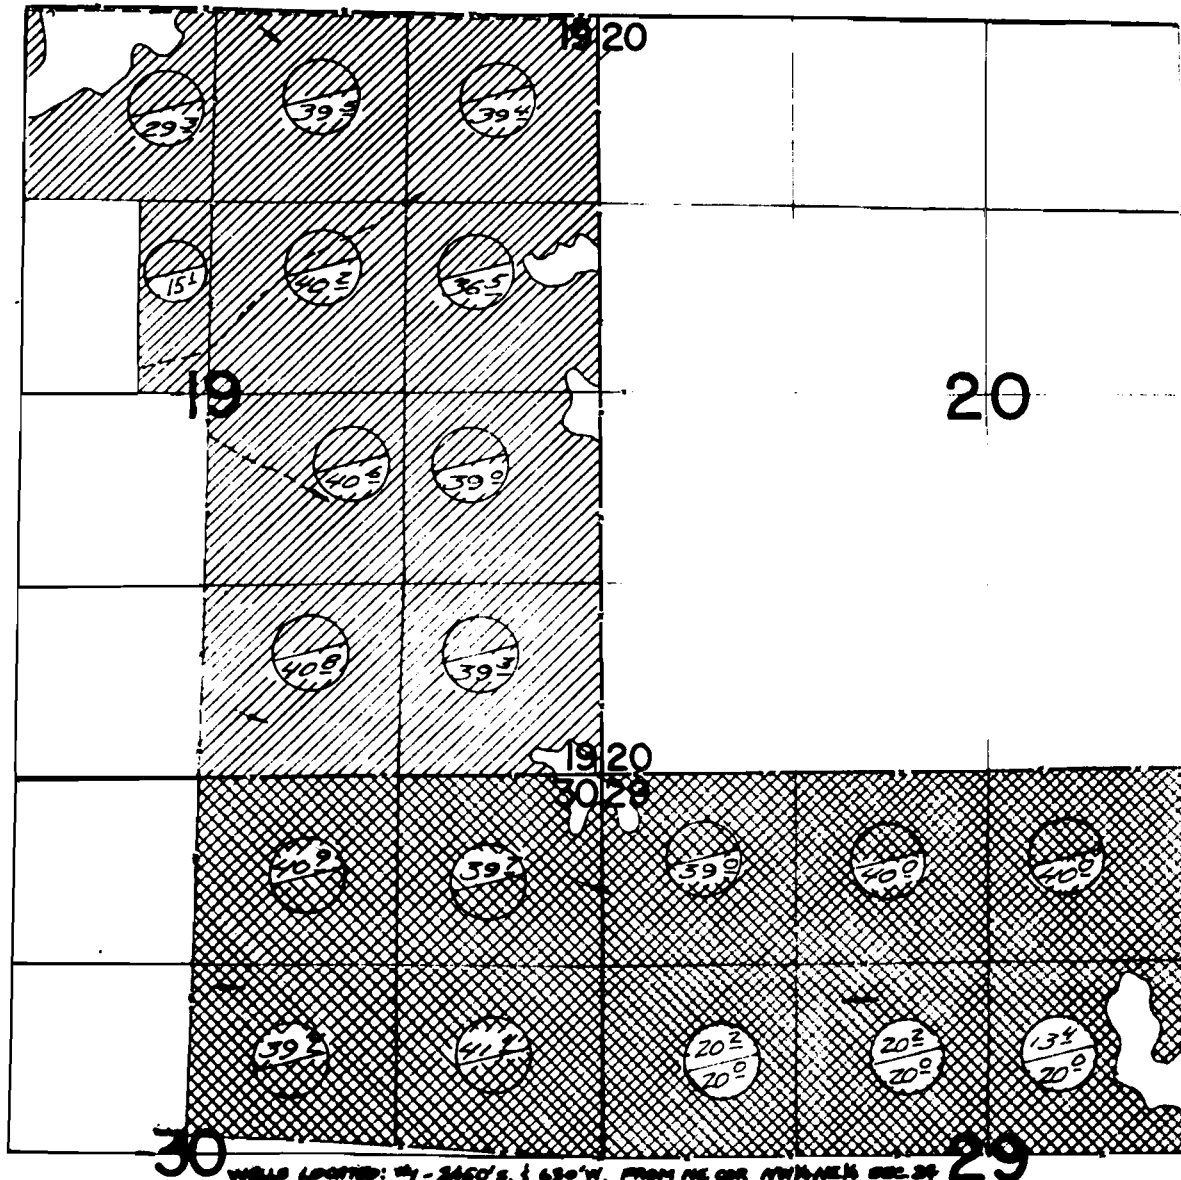

FINAL PROOF SURVEY UNDER

Application No. G-5208 Permit No. G-5073
 IN NAME OF

JOHN M. CAMPBELL

Surveyed SEPT. 18-19, 1968, by V. GARNER
JUNE 23, 1975 L. TOLL

copy