


T.23S. R.33E. W.M.

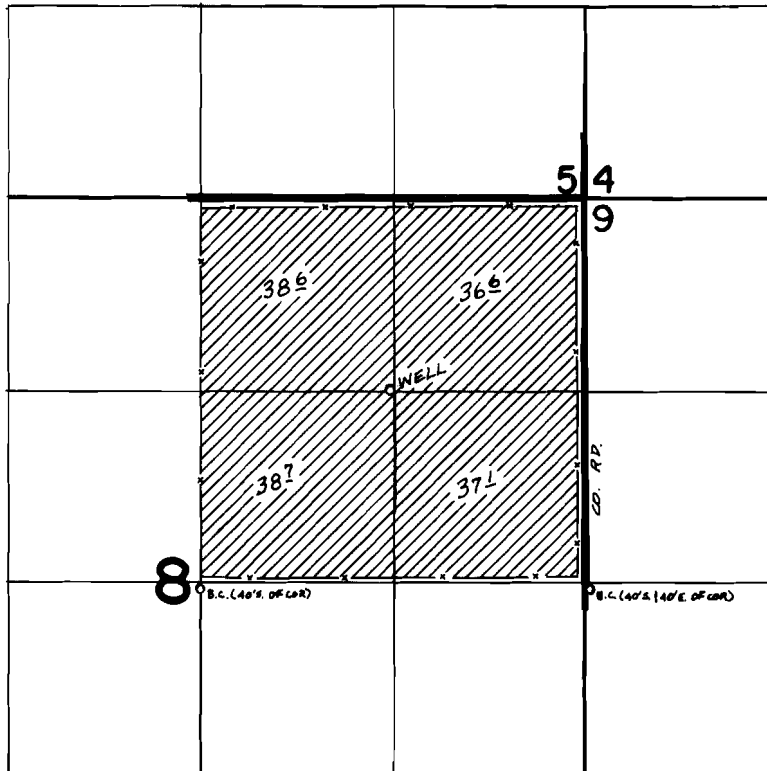

WELL LOC.: 1330' N. & 1300' E. FROM CTR. SEC. 8.

FINAL PROOF SURVEY
UNDER

Application No. G-5216 Permit No. G-5078
IN NAME OF

JOHN TEMPLE

Surveyed JUNE 26 1975, by L. TOLL