


# T.24S. R.31E. W.M.

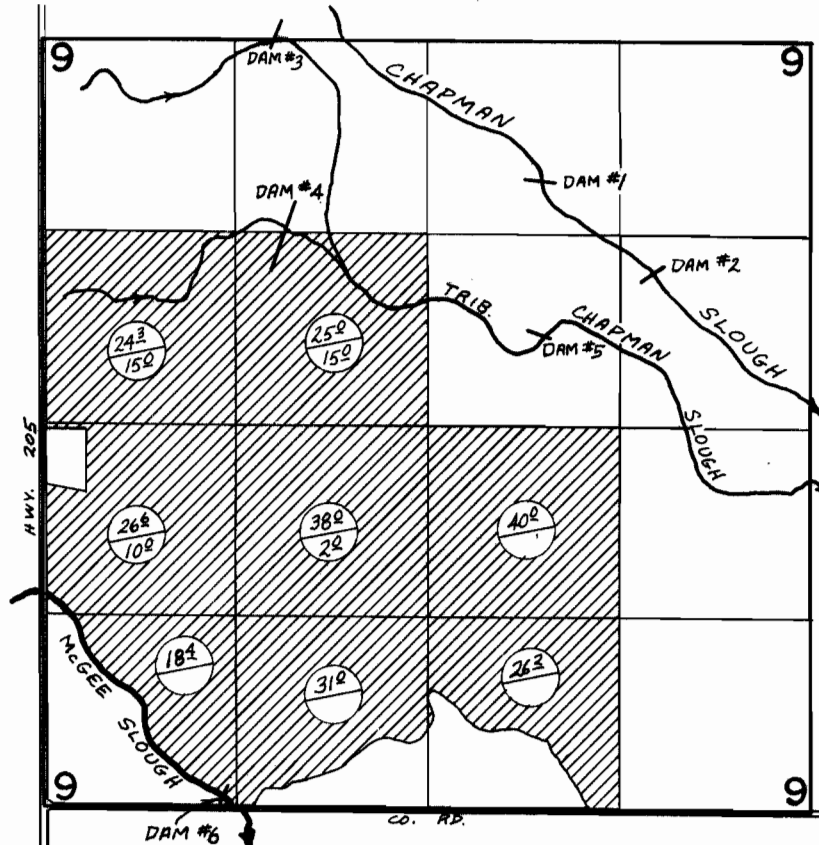

DAMS LOC: #1-4330'N. & 3450'E, #2-3700'N. & 4210'E, #3-5270'N. & 1600'E,  
 #4-3970'N. & 1680'E, #5-3260'N. & 3460'E, #6-80'N. & 1240'E.  
 ALL FROM SW COR SEC. 9.

 PERMIT #28812  
 EXISTING RIGHTS (DECREE, V. 9, P. 177)

## FINAL PROOF SURVEY UNDER

Application No. 38643 Permit No. 28812  
 IN NAME OF

RIDDLE RANCH, INC.

Surveyed JUNE 25 1975, by L. TOLL