


T.24&25S. R.36E. W.M.

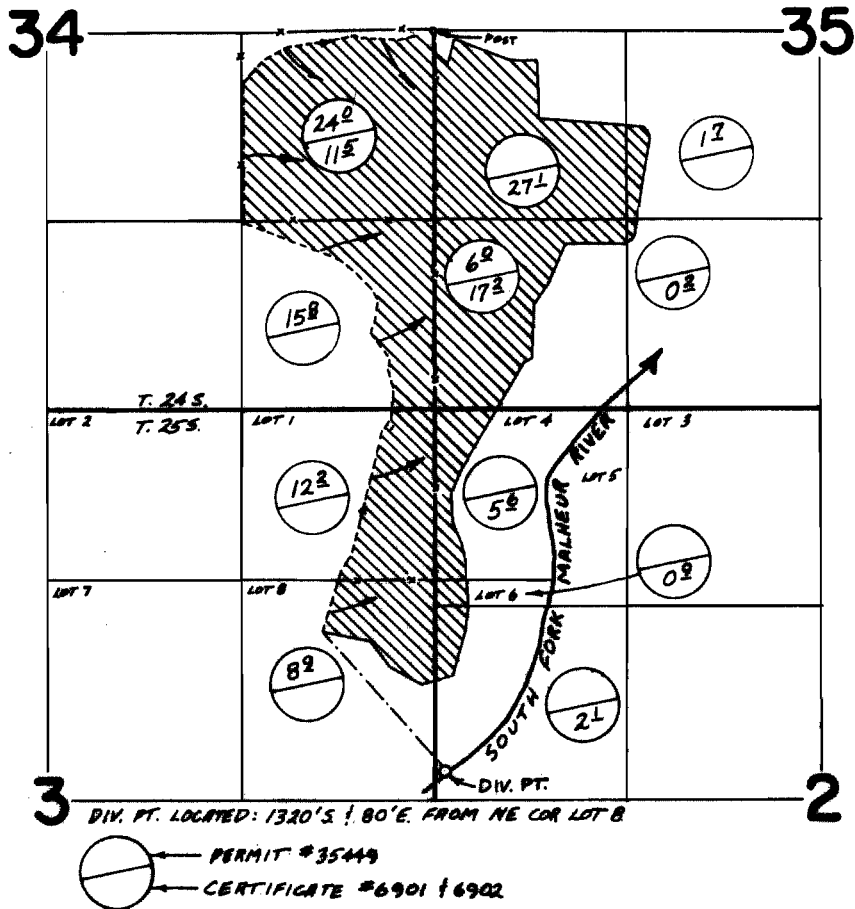

FINAL PROOF SURVEY
UNDER

Application No. 47319 Permit No. 35449
IN NAME OF

T. A. DOMAN

Surveyed SEPT. 13 1968, by W. J. RUPPERT
JUNE 26 1975 L. M. TOLL