

UNITED STATES
DEPARTMENT OF THE INTERIOR
BUREAU OF LAND MANAGEMENT


SECTION

24
SW $\frac{1}{4}$ NE $\frac{1}{4}$

Oregon State Water Filings

TOWNSHIP 23 RANGE 24E, W. M.

North

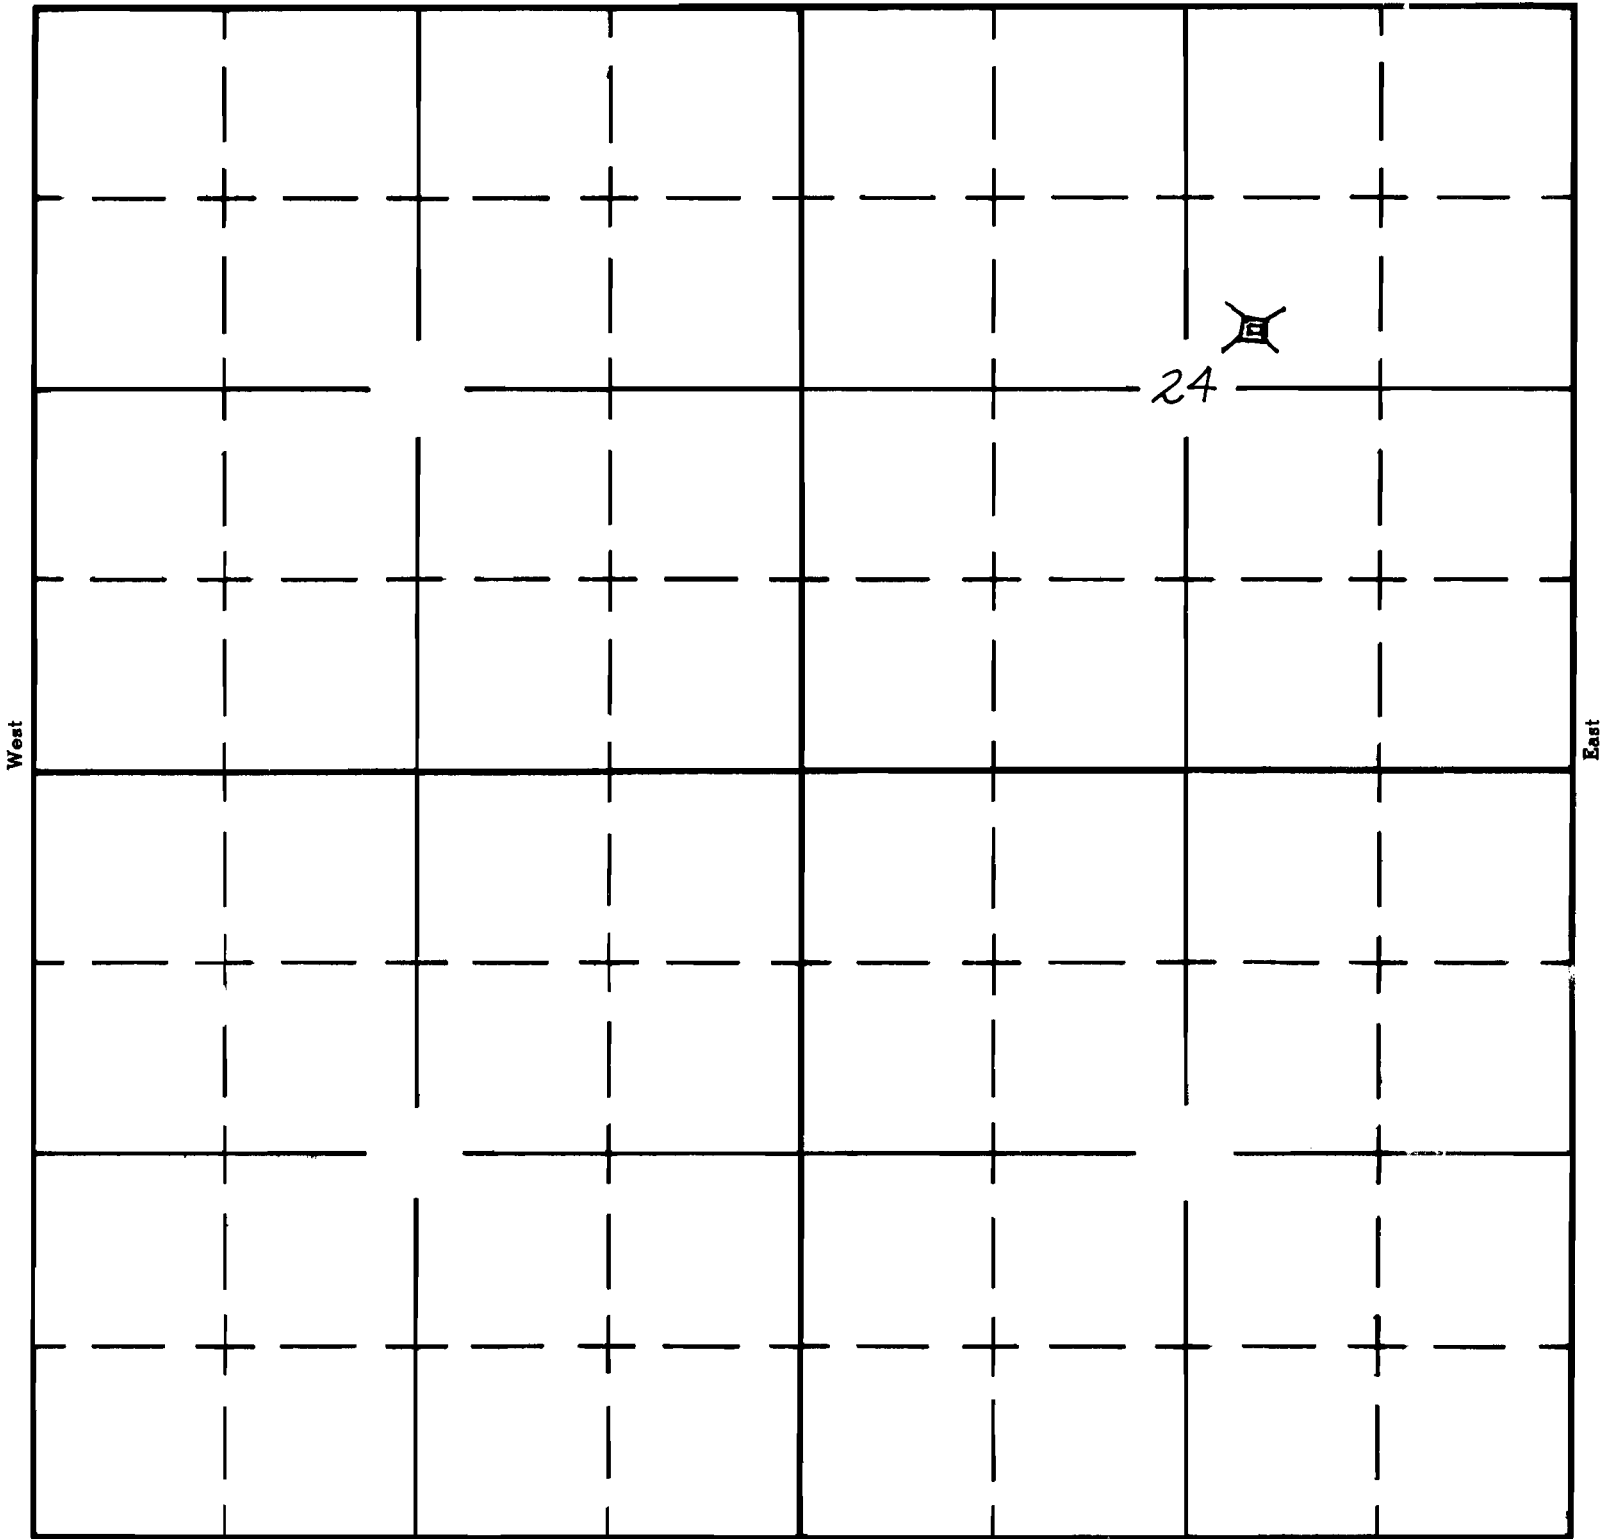

Application No. R-34324
Permit No. R-2571

APPLICATION No.
PERMIT No.