


T.37S. R.2W. W.M.

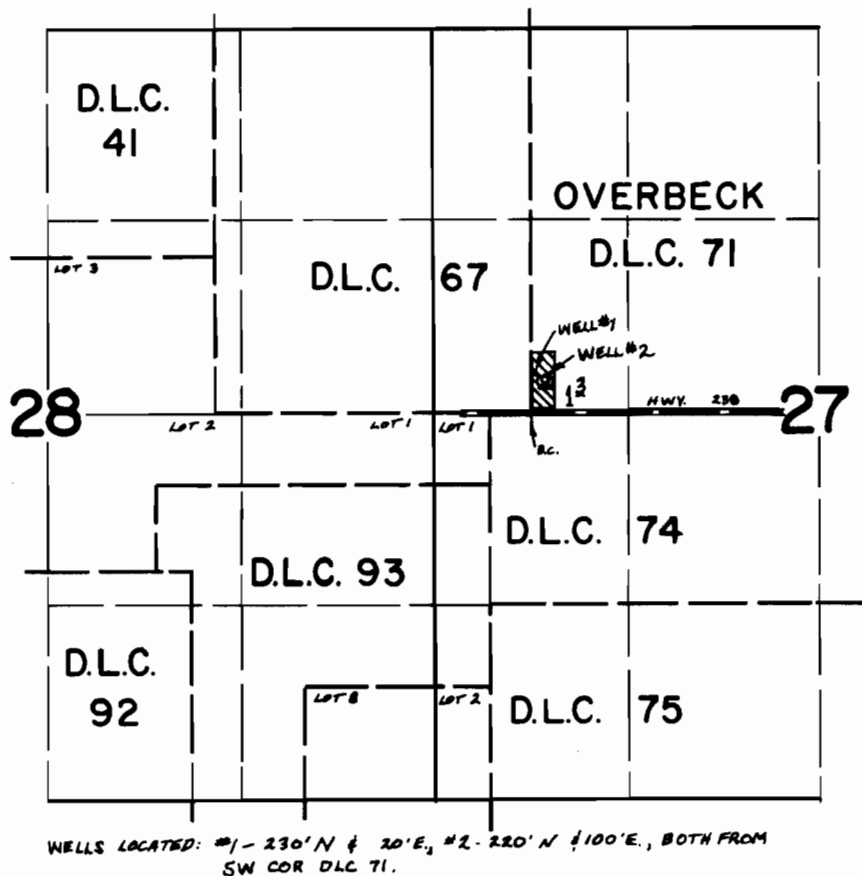

FINAL PROOF SURVEY UNDER

Application No. G-5523 Permit No. G-5193
IN NAME OF

EDWARD L. CATE

Surveyed OCT. 29 1975, by L. TOLL