


T.38S. R.3W. W.M.

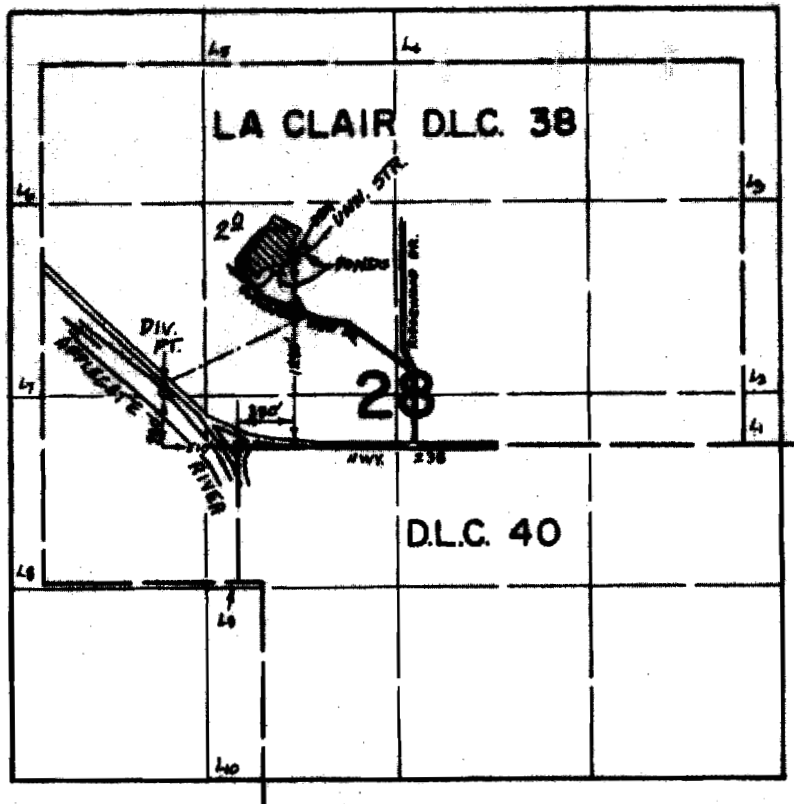

**FINAL PROOF SURVEY
UNDER**

Application No. 42092 Permit No. 31498
48226 36210
IN NAME OF

ALBERT R. WORKMAN

Surveyed AUG. 11, 1975, by L. TOLL