


T.38S. R.3W. W.M.

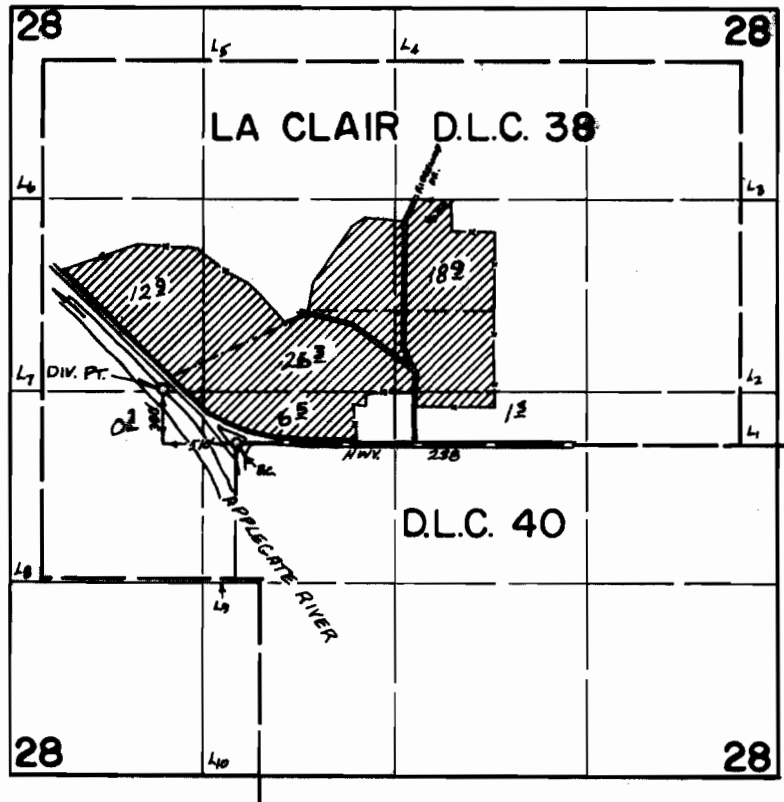

FINAL PROOF SURVEY
UNDER

Application No. 45100 Permit No. 33703
IN NAME OF

RUSSELL R. AND/OR GENEVIEVE MEE

Surveyed AUG. 11. 1975. by L. TOLL