


T.37S. R.2W. W.M.

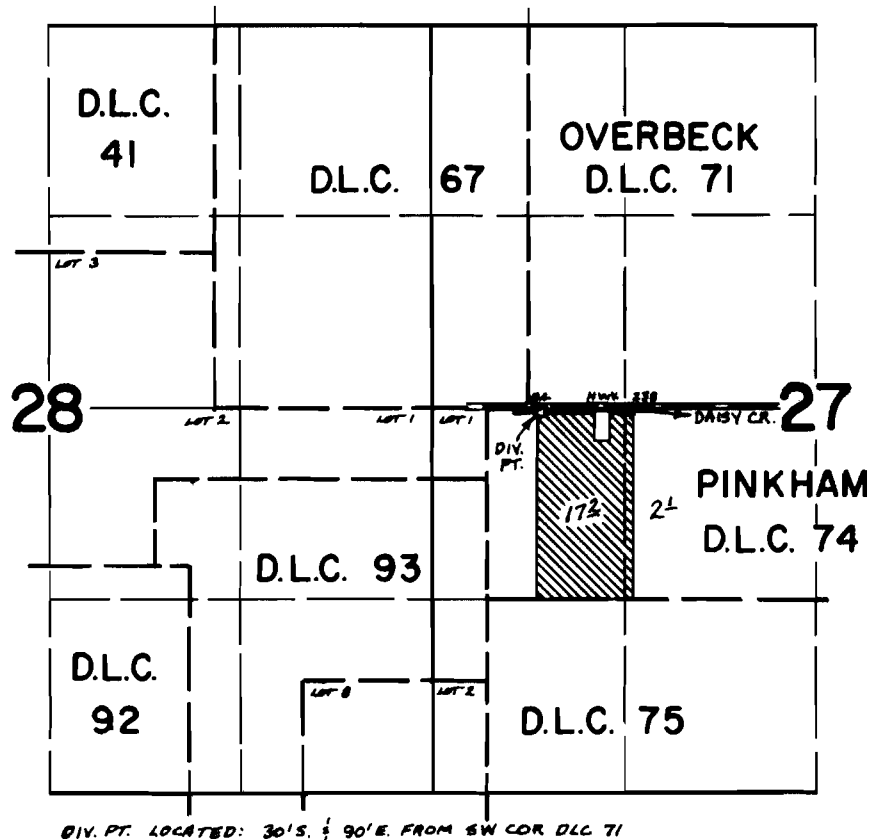

FINAL PROOF SURVEY
UNDER

Application No. 45763 Permit No. 33843
IN NAME OF

DUNBAR CARPENTER

Surveyed NOV. 1 1975, by L. TOLL