


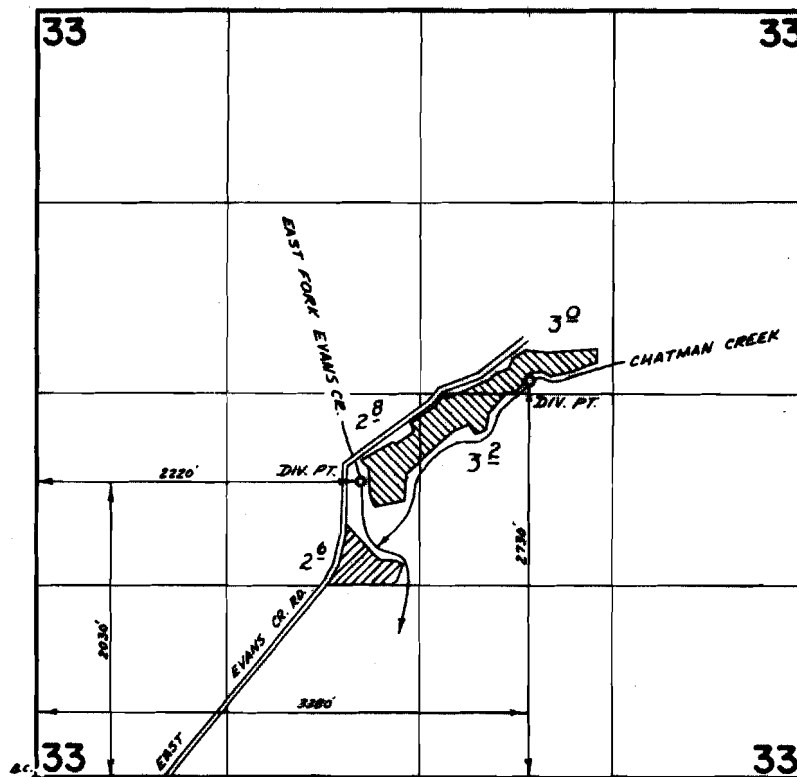

T.33S., R.2W., W.M.



-  PRIMARY CHATMAN CREEK
SUPPLEMENTAL E. FORK EVANS CR.
-  PRIMARY E. FORK EVANS CR.

FINAL PROOF SURVEY UNDER

Application No. 46319 Permit No. 34608
IN NAME OF

BURT K. AND/OR ALICE R. HANSEN

Surveyed Aug. 26 1975, by D. Norby