


T.39&40S.R.2E.W.M.

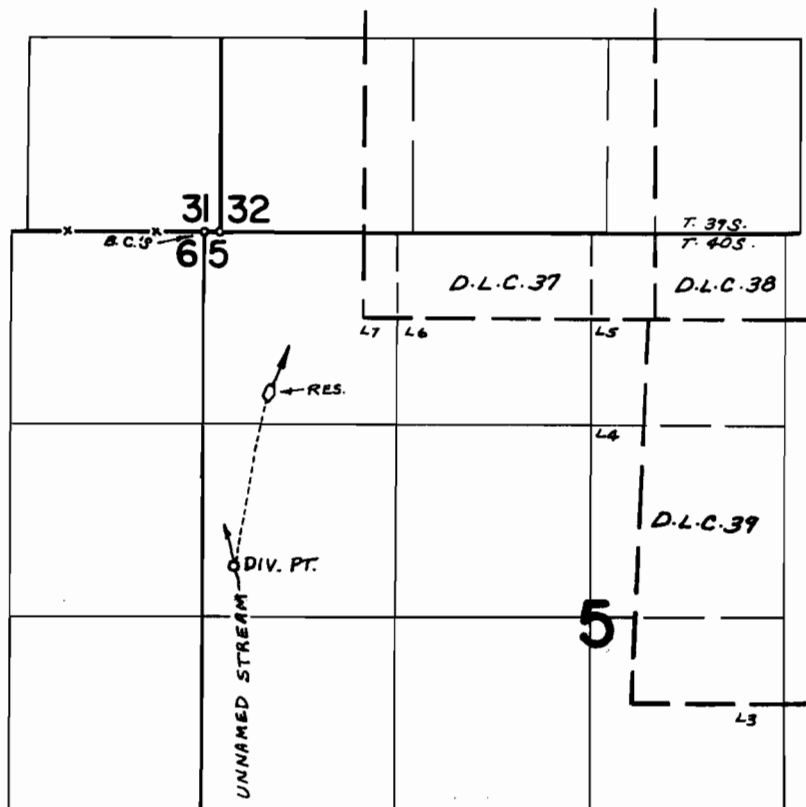

DIV. PT. LOC: 2290'S. & 220'E. FROM N.W. COR. SEC. 5
RES. LOCATED: 1050'S. & 470'E. FROM N.W. COR. SEC. 5

FINAL PROOF SURVEY UNDER

Application No. R-46670 Permit No. R-5576
46671 35868
IN NAME OF

ADRIEN BARAIS

Surveyed SEPT. 19, 1974, by R. MUCKEN
NOV. 6, 1975 L. TOLL