


T. 37S. R. 1W. W.M.

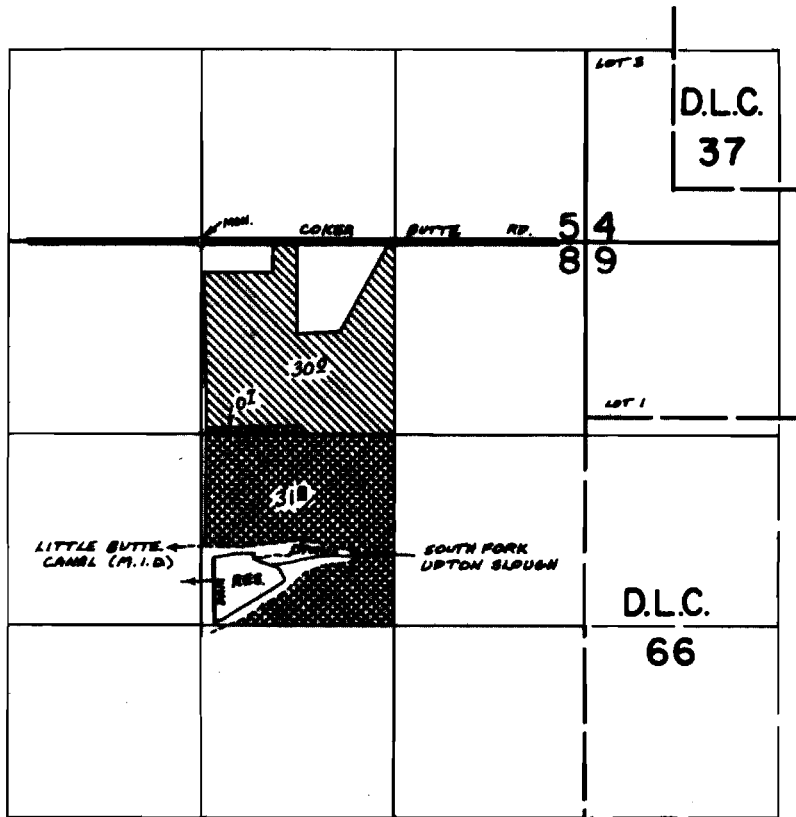

DAM LOC: 2830'S. & 80'E. FROM N 1/4 COR. SEC. 8
 CANAL DN. PT. (FROM S. FORK LITTLE BUTTE CR.) LOC: 600'S. & 525'W. FROM
 E. 1/4 COR. SEC. 29, T. 36 S., R. 2E., W.M.

- TEMPERATURE CONTROL FROM S. FORK LITTLE BUTTE CR. AND S. FORK UPTON SLOUGH
- SUPPLEMENTAL IRRIGATION FROM S. FORK UPTON SLOUGH

FINAL PROOF SURVEY UNDER

R-45725 R-5420
 45726 34121
 Application No. 47122. Permit No. 35285.
 IN NAME OF

DUNBAR CARPENTER

Surveyed NOV. 3, 1975. by L. I. OLL