


T.38S. R.4W. W.M.

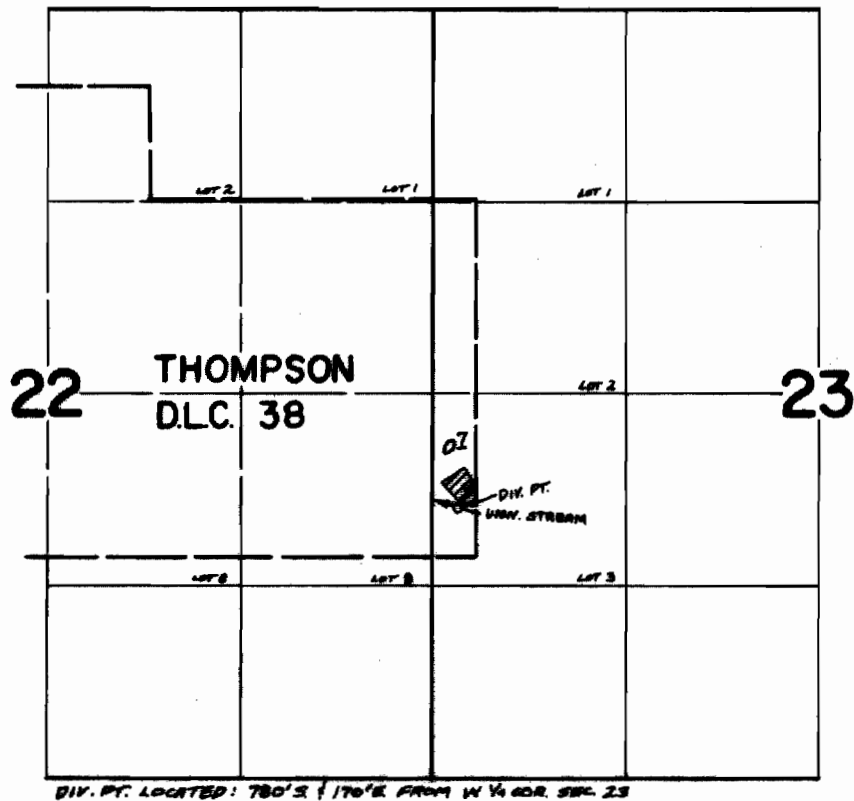

**FINAL PROOF SURVEY**  
UNDER

Application No. 49440 Permit No. 37039  
IN NAME OF

E. J. & L. G. BILLESBACH

Surveyed AUG. 8 1975, by L. TOLL