


T. 38S. R. 4W. W.M.

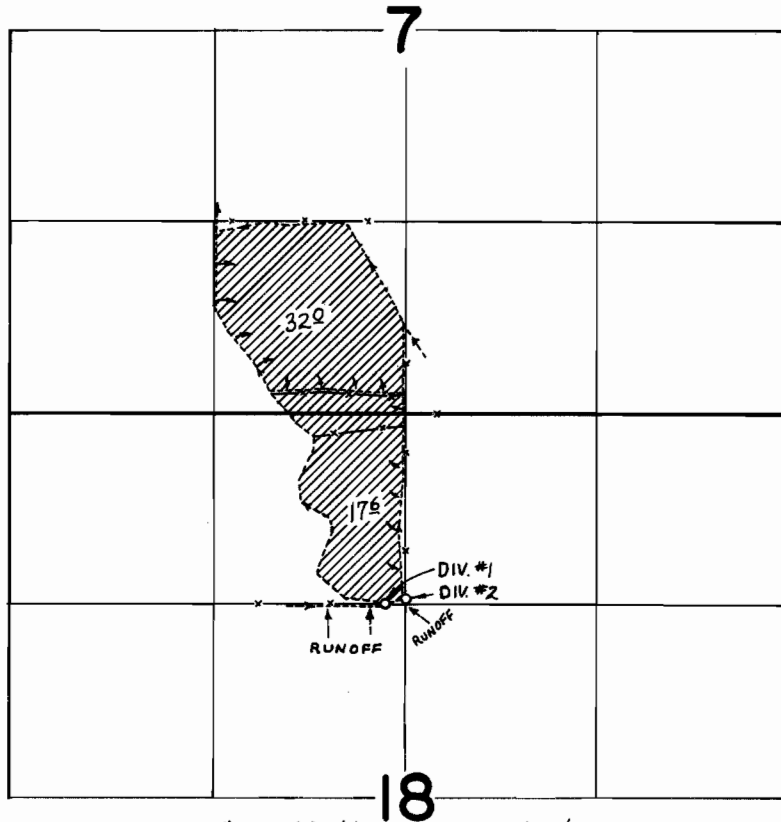

DIV. PTS. LOCATED: #1- 10' N. & 140' W., #2- 30' N. & 10' W., BOTH FROM SE COR. NE 1/4 NW 1/4 SEC. 18.

FINAL PROOF SURVEY
UNDER

Application No. 49824 Permit No. 37482
IN NAME OF

MARTHA J. WHITE

Surveyed AUG. 6, 1975, by L. TOLL