


T. 39S. R. 3W. W.M.

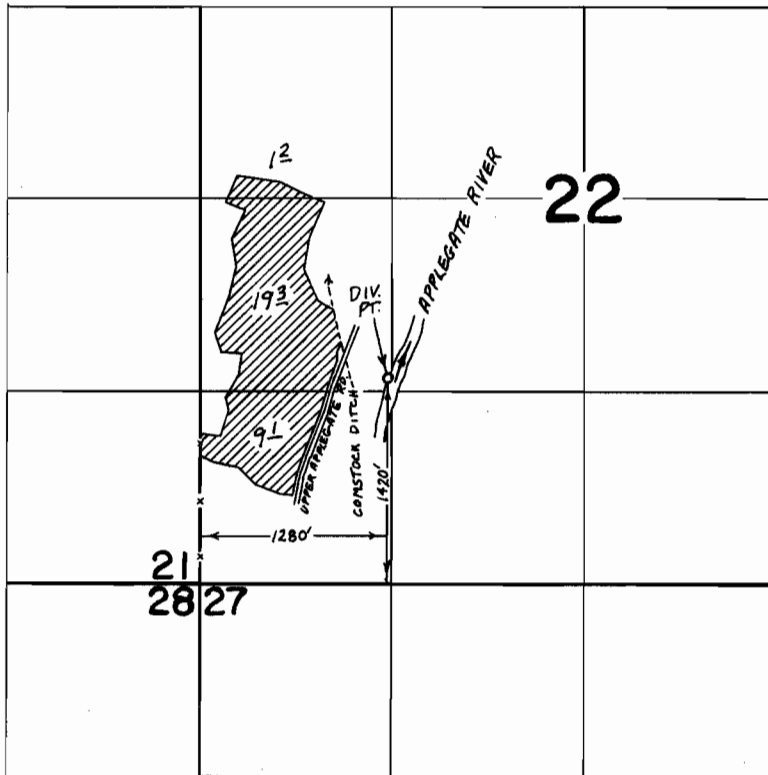

FINAL PROOF SURVEY
UNDER

Application No. 49898 Permit No. 37551
IN NAME OF

FRED L. OR NANCY K. STRAUBE

Surveyed NOV. 5 1975, by L. TOLL