


T.11S., R.13E., W.1M.

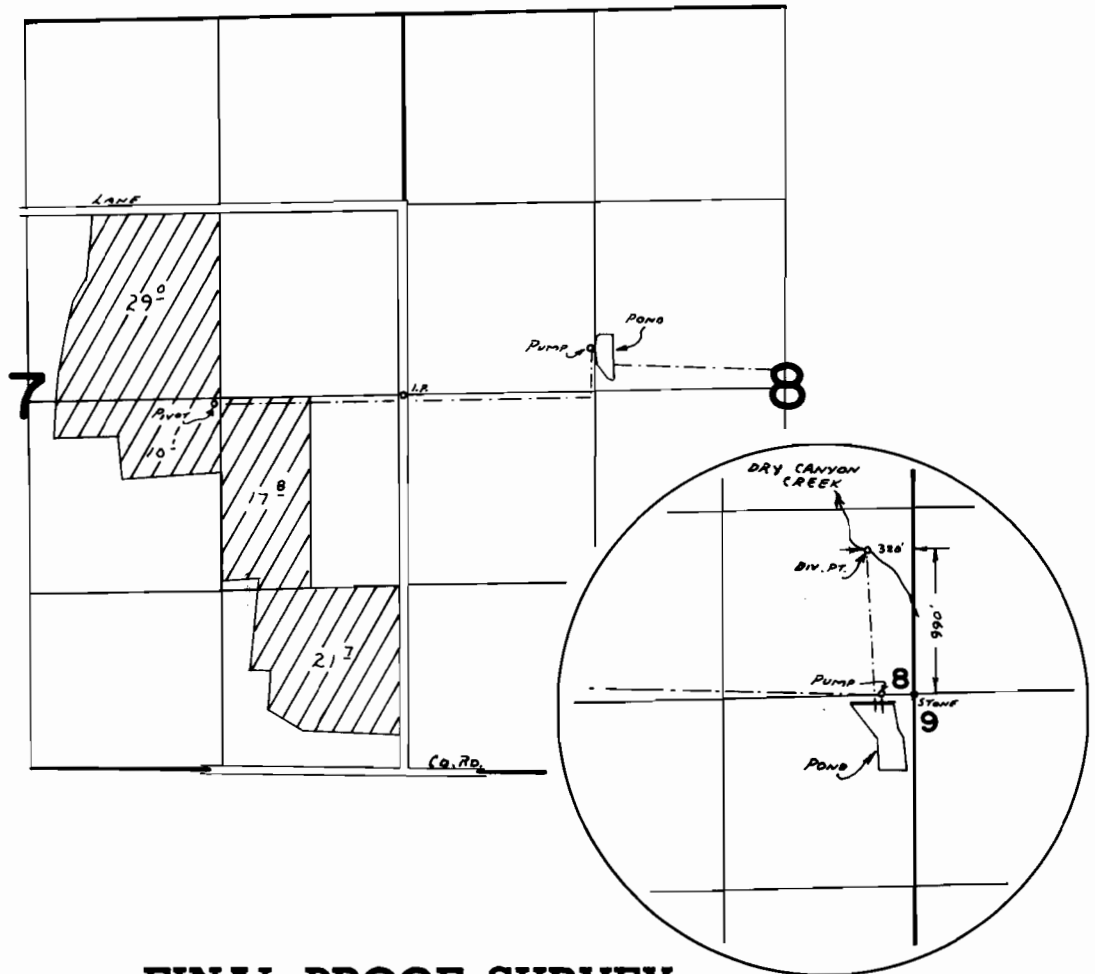

FINAL PROOF SURVEY
UNDER

Application No. **44333**. Permit No. **32742**.
IN NAME OF

BILLY J. TOWERY

Surveyed **JUNE 16 1975**, by **L. E. GOULD**