


T.16S. R.5W. W.M.

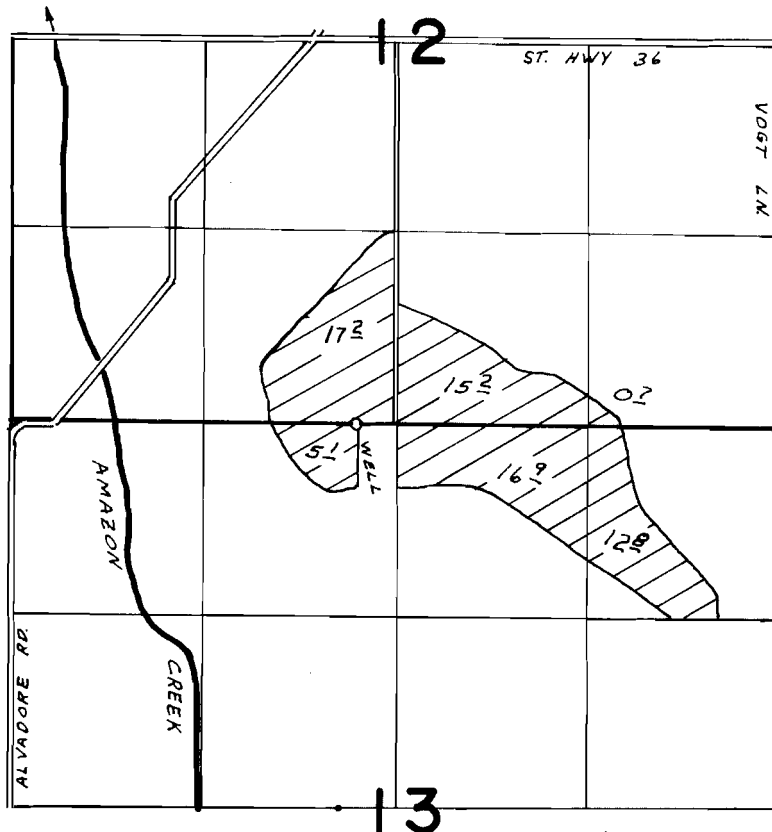

WELL LOC. 10' S & 280' W. FROM N $\frac{1}{4}$ COR, SEC. 13

FINAL PROOF SURVEY
UNDER

Application No. G-5582 Permit No. G-5210
IN NAME OF

EVERETT FALK

Surveyed SEP 26 1975, by L.H. NUNN