


T.37 S. R.5 W. W.M.:

T.38 S. R.4 W. W.M.

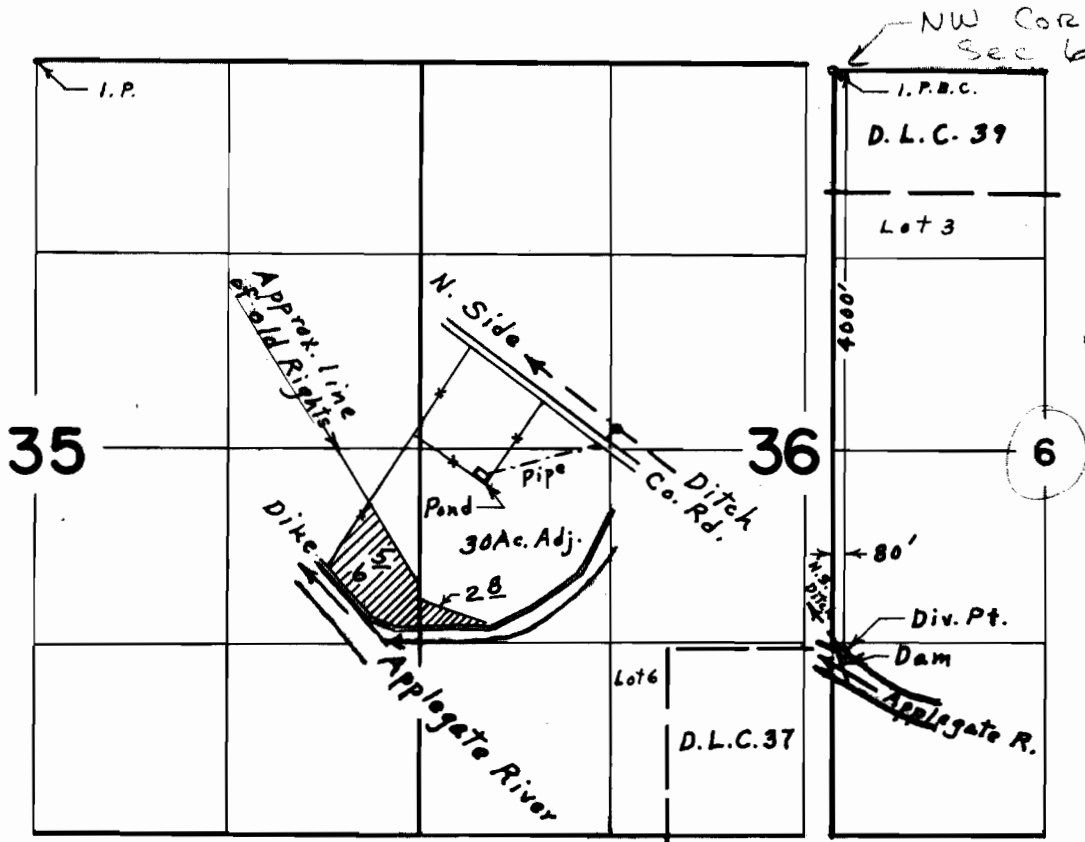

FINAL PROOF SURVEY UNDER

Application No. 43462 Permit No. 32508
IN NAME OF

CHESTER T. & MARTHA RICE

Surveyed May 17, 1975, by L. E. Gould