


T.40S.,R.8W.,W.M.

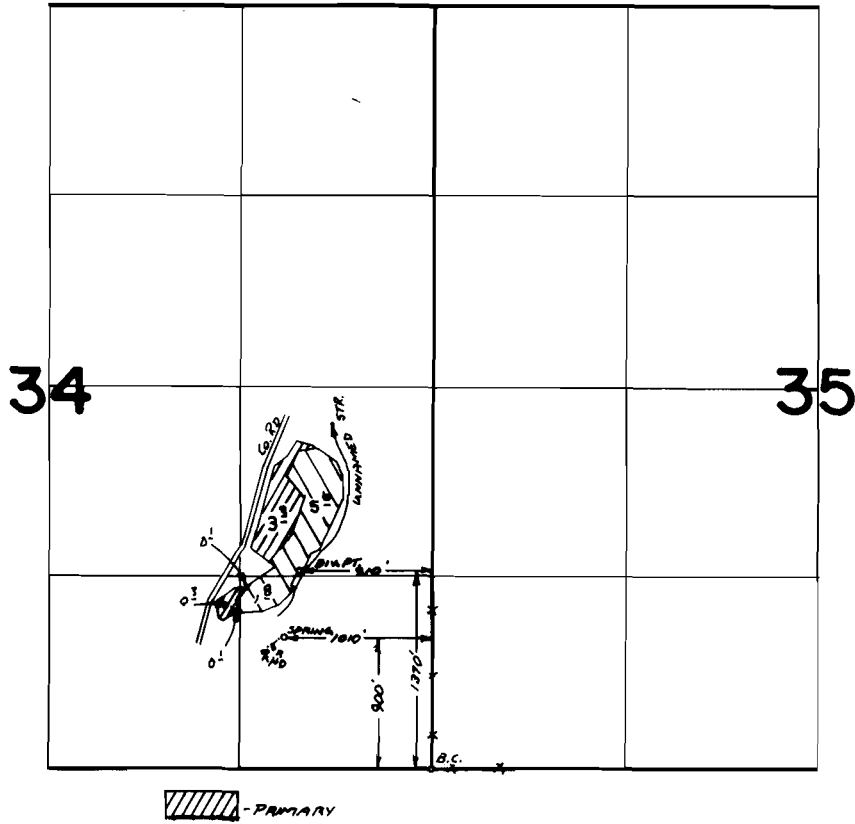

**FINAL PROOF SURVEY**  
UNDER

Application No. 44097 Permit No. 32942  
46245 34550  
IN NAME OF

GOLDEN V. MAYLONE

Surveyed May 2 1975, by L. Toll