


T.40S.,R.8W.,W.M.

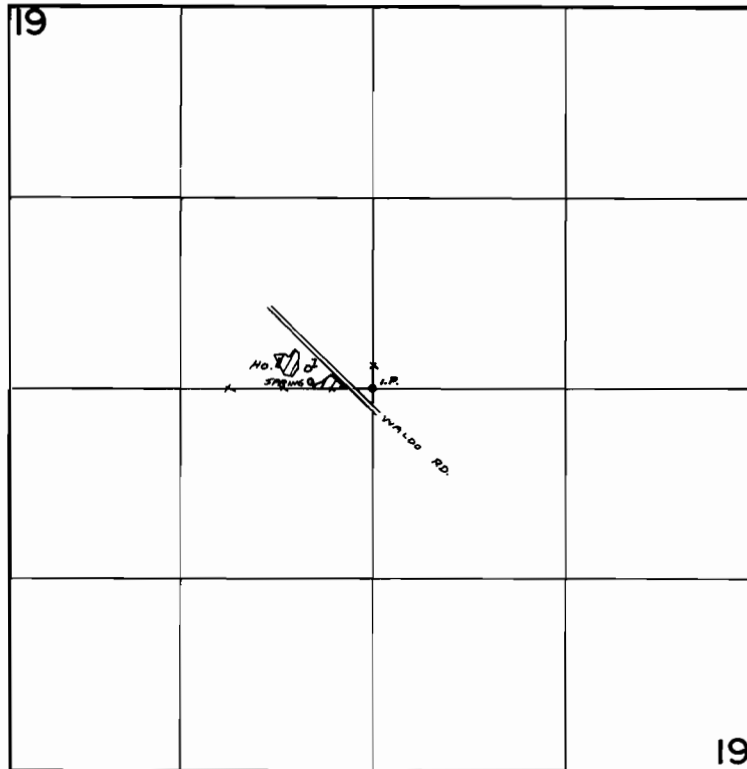

SPRING LOC: 60' N AND 420' W FROM CENTER SEC 19

FINAL PROOF SURVEY
UNDER

Application No. 44331 Permit No. 33105
IN NAME OF

VERNON EDWARD & JESSIE M. NUNEMAKER

Surveyed April 30 1975, by L. Toll