


T.40S.,R.8W.,W.M.

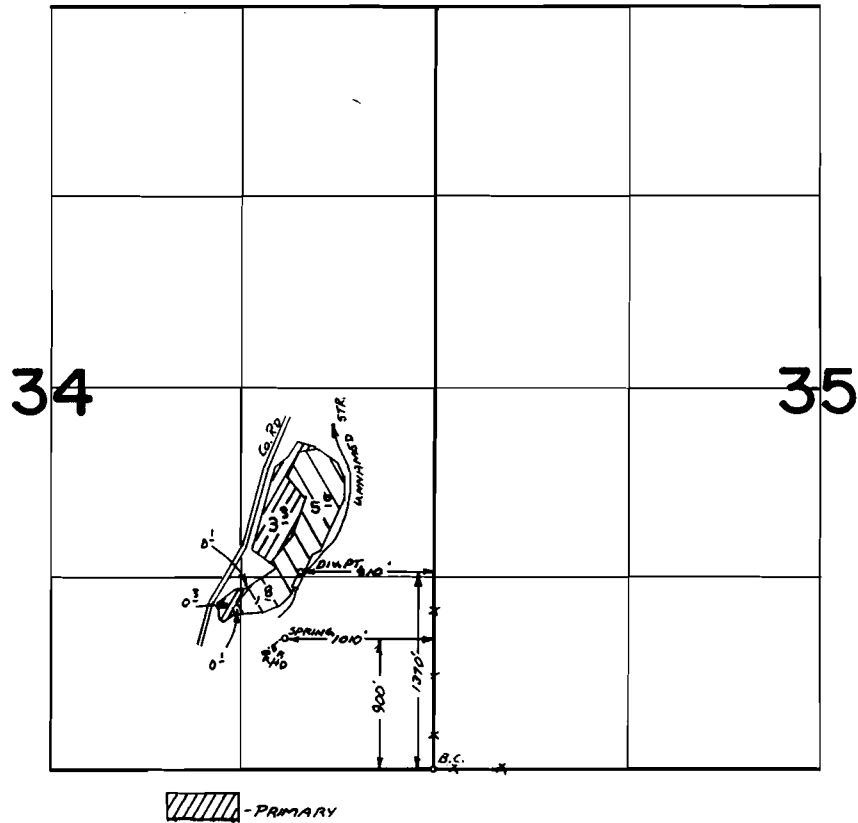

FINAL PROOF SURVEY
UNDER

Application No. 44097 Permit No. 32942
46245 IN NAME OF 34550

GOLDEN V. MAYLONE

Surveyed MAY 2 1975, by L. Tall