

e


34828

R-5569

44730

44731

T.35S. R.11E. W.M.

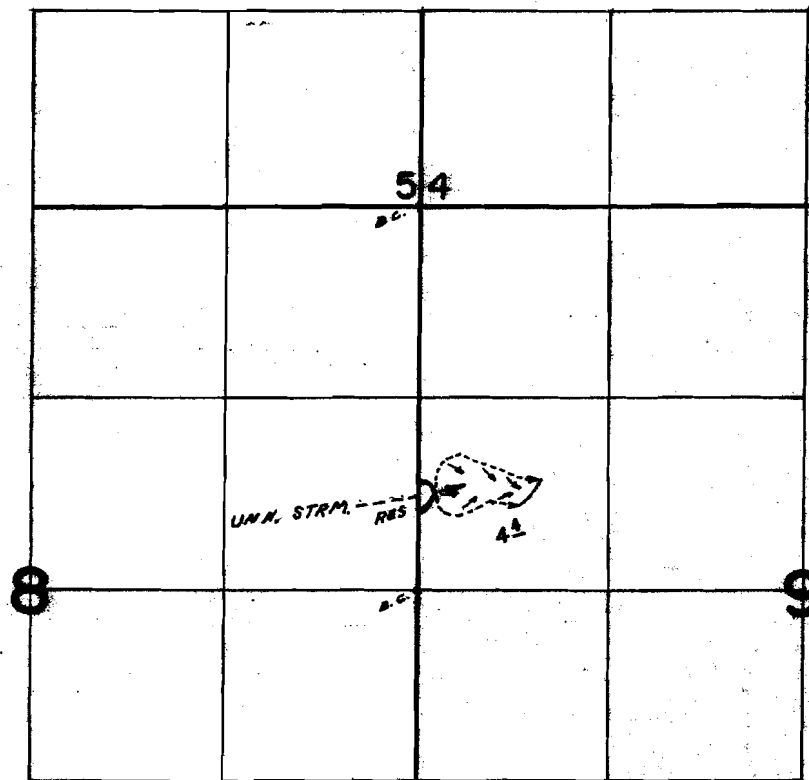

DIV. PT. LOC. 670' N. & 120' E. FROM W 1/4 COR. SEC. 9

FINAL PROOF SURVEY UNDER

R-44606

R-5569

Application No. 44607.. Permit No. 34828..
IN NAME OF

CHARLES E. HICKS

Surveyed JUN. 7. 1975, by L.H. NUNN

