


T.32S. R.8E. W.M.

Williamson Co. Musc.

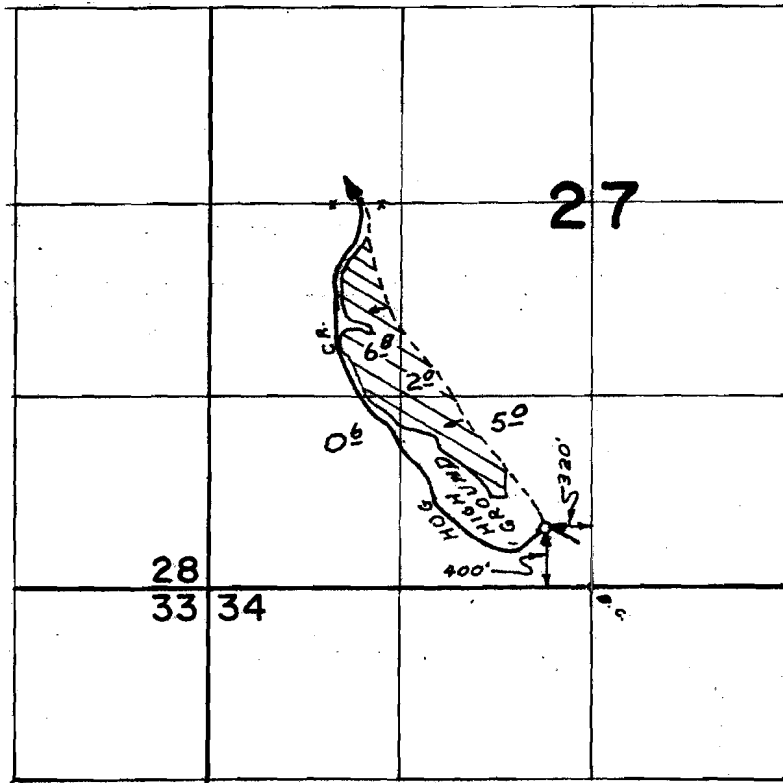

FINAL PROOF SURVEY UNDER

Application No. 47202 Permit No. 34950
IN NAME OF

HARRY CLARKSON

Surveyed OCT. 24, 1974, by L.H. NUNN