


35928
44733

T.37S, R.88E, W.M.

Source:

Upper Klamath Lake

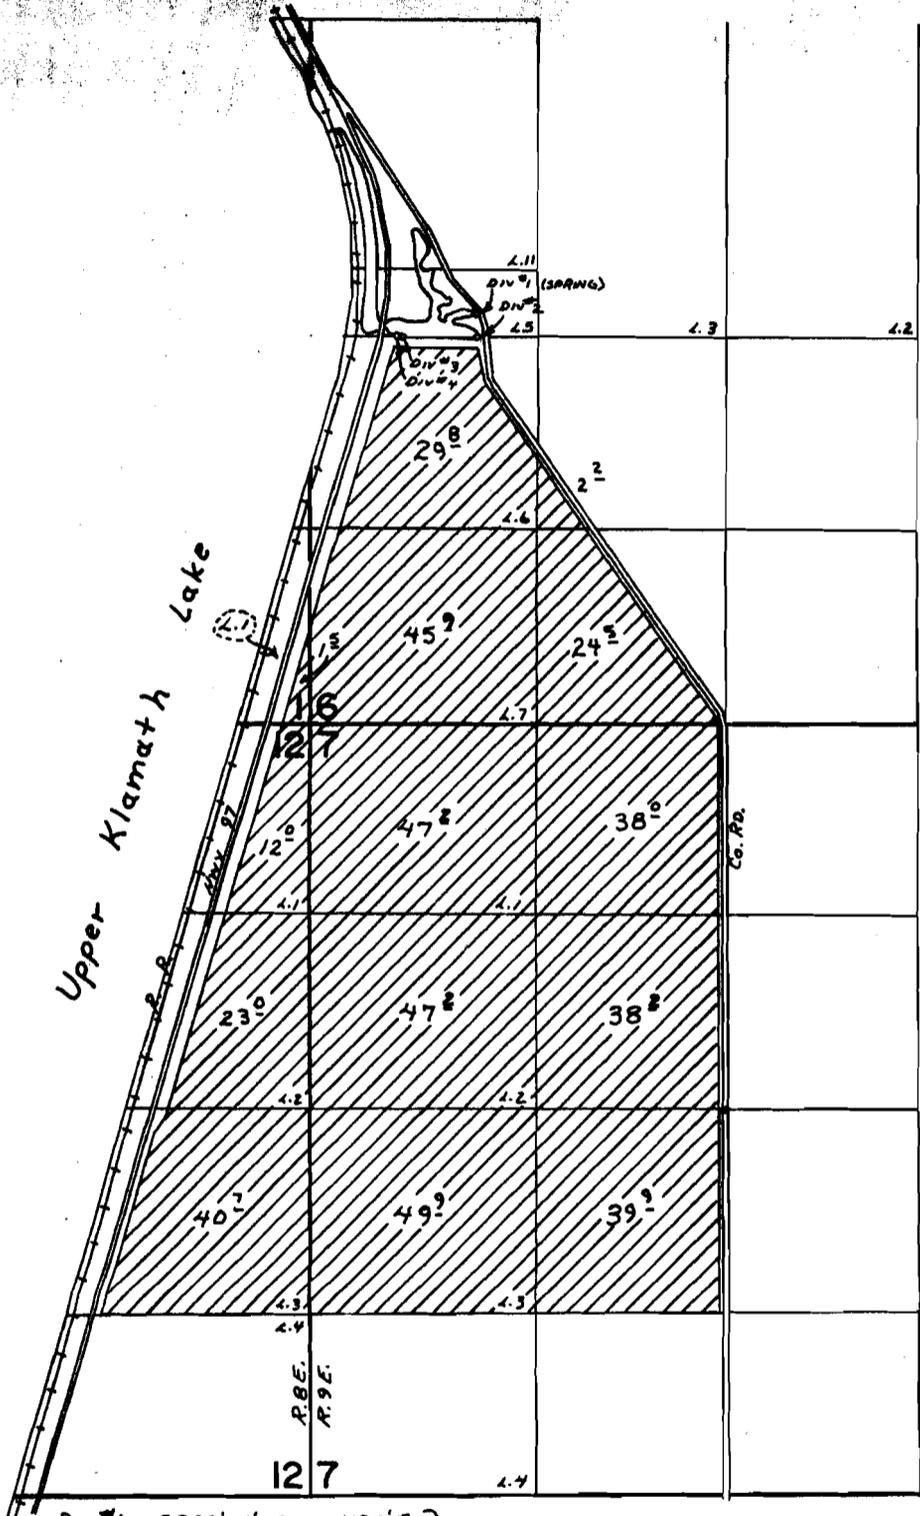

DIV #1 - 2800' N AND 1130' E
 DIV #2 - 2640' N AND 1140' E
 DIV #3 - 2640' N AND 640' E
 DIV #4 - 2640' N AND 600' E

FROM SW COR SEC 6

FINAL PROOF SURVEY UNDER

Application No. 48878 Permit No. 35928
IN NAME OF

Cont # 44733

FREDERIC B. ROBERTA SCHILDMAYER

Surveyed July 11, 1975, by L. E. Gould