


6-4280
44734

T.408 41S. R.16E. W.M.

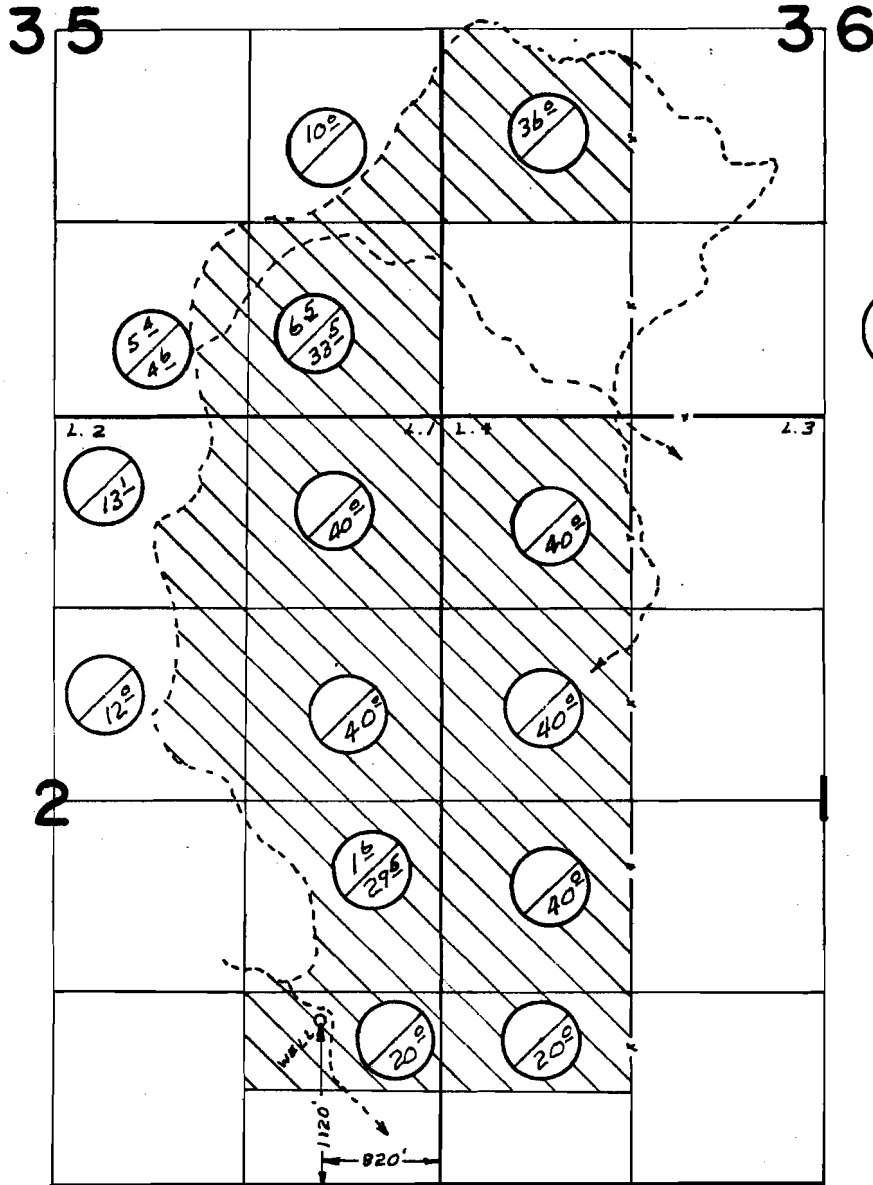

wilow cke. woods

FINAL PROOF SURVEY UNDER

Application No. G-4556 Permit No. G-4280
IN NAME OF

LEO H. ALBERTSON, SR.

Surveyed JUL. 15. 1975, by L.H. NUNN