


7-710.1
44735

T.39S. R.18E. W.M.

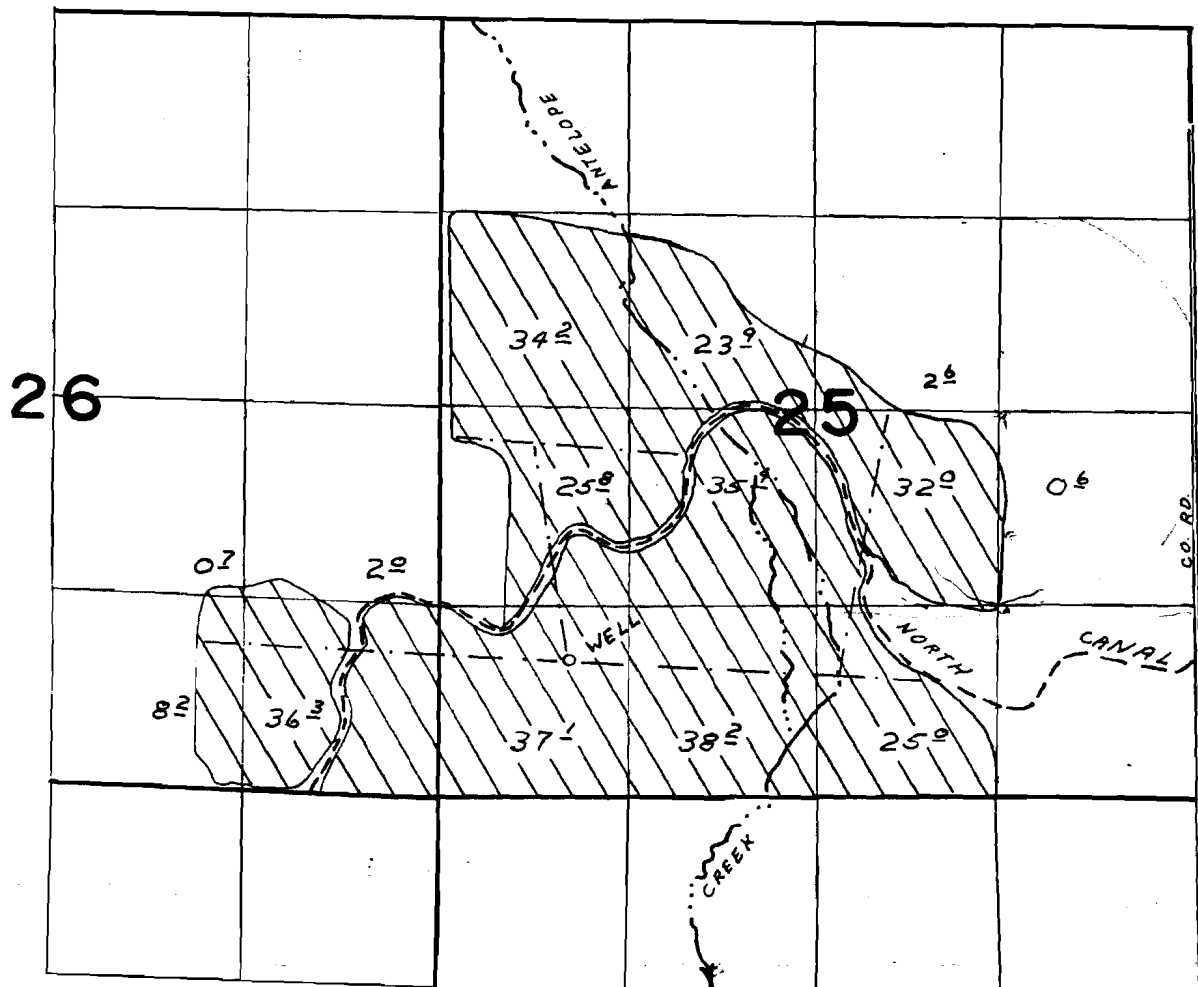

WELL LOC. 940' N & 890' E FROM THE SW COR. SEC. 25.

FINAL PROOF SURVEY
UNDER

Application No. G-4914 Permit No. G-4631
IN NAME OF

LEO H. ALBERTSON S.R.

Surveyed JUL 15 1975, by L.H. NUNN