


34122

44740

T.39S. R.19E. W.M.

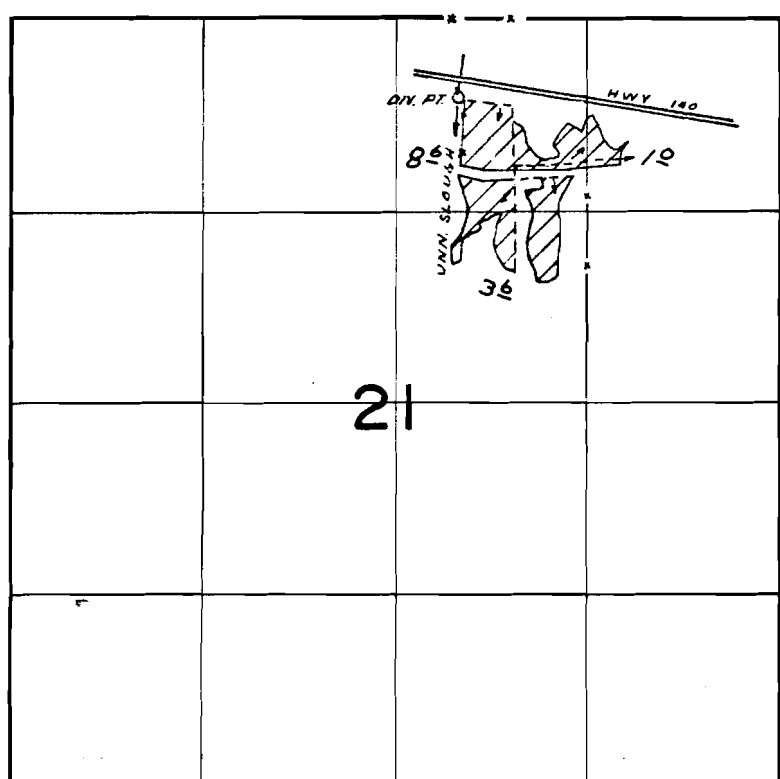

DIV. PT. LOC. 550'S & 2200' W FROM NE COR. SEC. 21

FINAL PROOF SURVEY
UNDER

Application No. 45747 Permit No. 34122
IN NAME OF

ROBERT K. & ISABELLE B. BARRY

Surveyed JUL. 11 1975, by L.H. NUNN