


T.38S.,R.24E.,W.M.

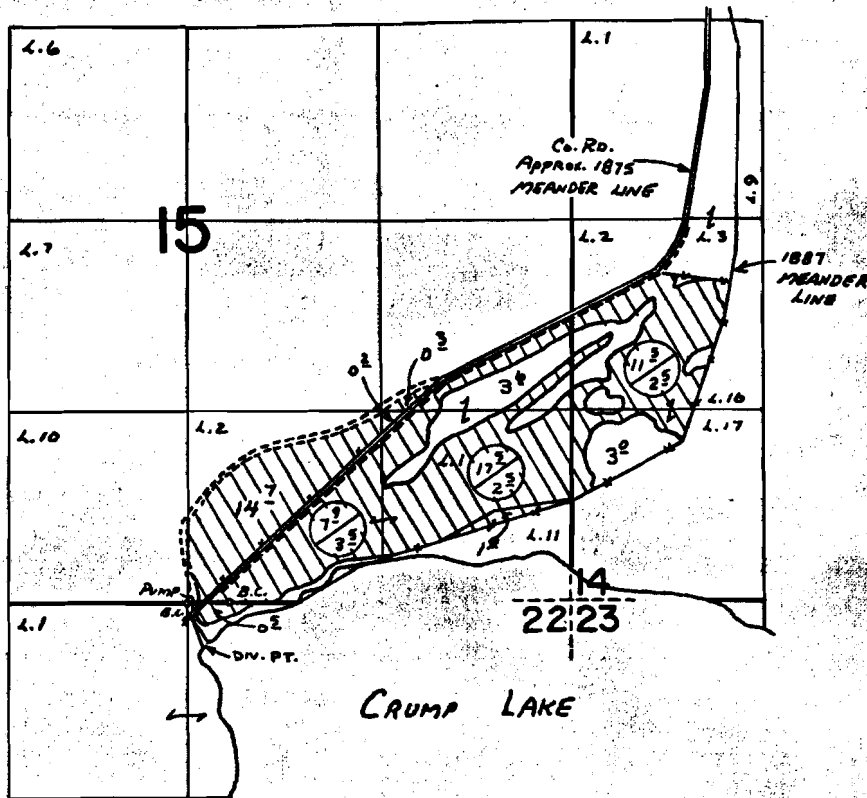

A - COVERED UNDER THIS APPLICATION
B - COVERED BY CERT. 9441

DIV PT: 290'S & 100'E from N $\frac{1}{4}$ cor Sec 22

FINAL PROOF SURVEY UNDER

Application No. 46952. Permit No. 35113. Cert # 44741
IN NAME OF

JOHN R. LANE

Surveyed Oct. 15, 1915, by L. T. Hall

CH2-688-81
PTS 1975-W